


T. 10 S. R. 6 W. W. M.

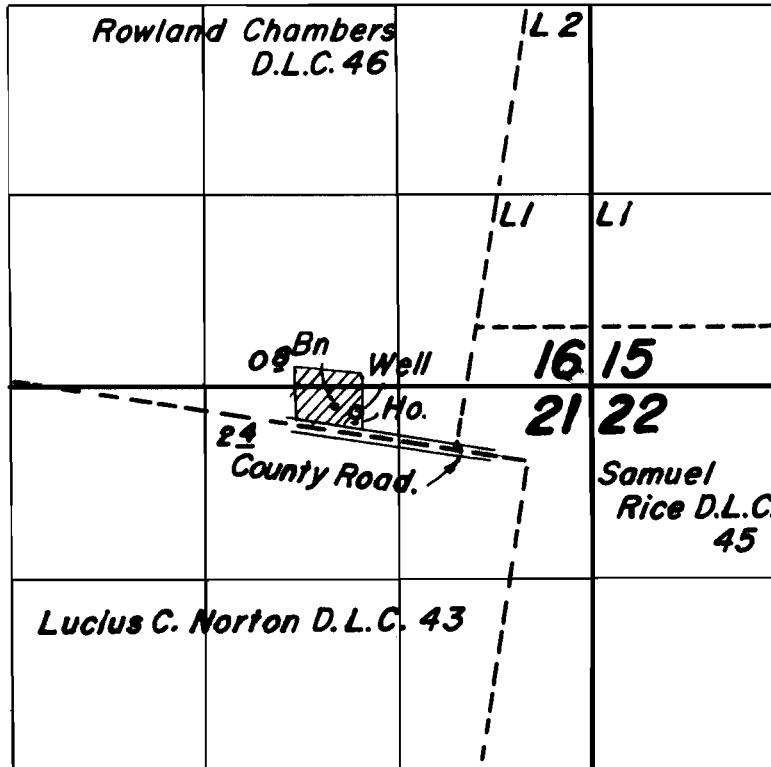

FINAL PROOF SURVEY
UNDER

Application No. 6 1764 Permit No. 6 1616
IN NAME OF

John Maloney

Surveyed May 24 1963, by Floyd L. Sigmond