


T.14S., R.5W., W.M.

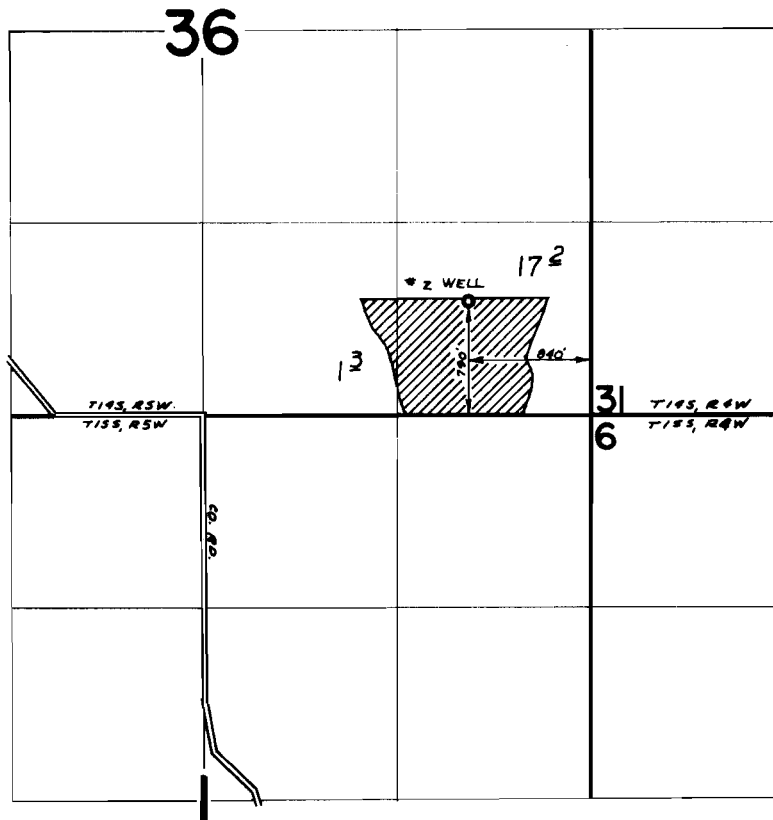

FINAL PROOF SURVEY
UNDER

Application No. G-3953 Permit No. G-3709
IN NAME OF

GLEN & NELLIE RICKARD

Surveyed Sept. 12, 1973, by D. NORBY