


T. 12 S.R. 5 W.W.M.

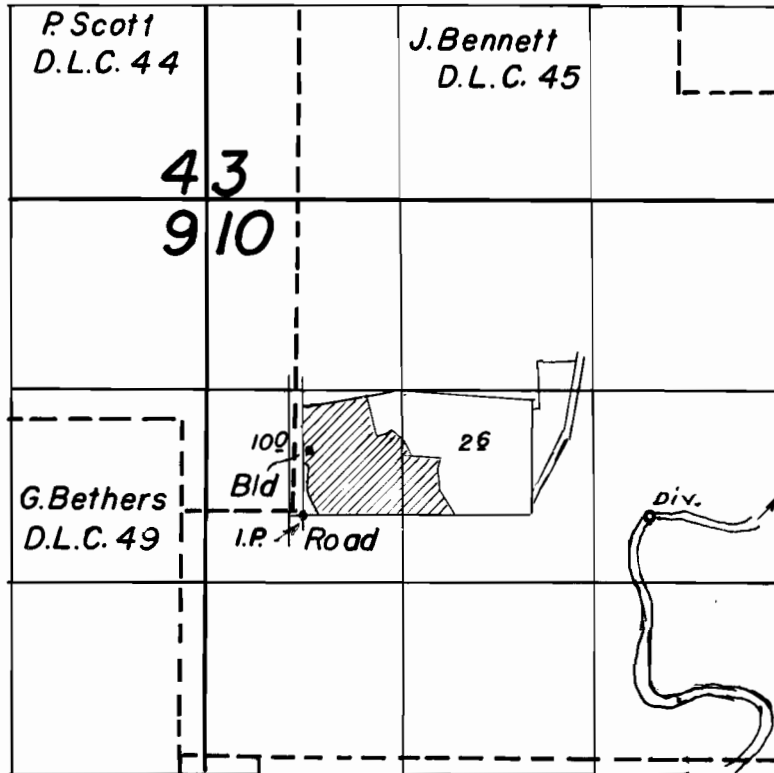

Mary's River

FINAL PROOF SURVEY
UNDER

Application No. 30523. Permit No. 24033
IN NAME OF

Benton Memorial Park Association

Surveyed Nov 20 1963, by *Floyd L. Siegmund*