


T.5S.R.1E.W.M.

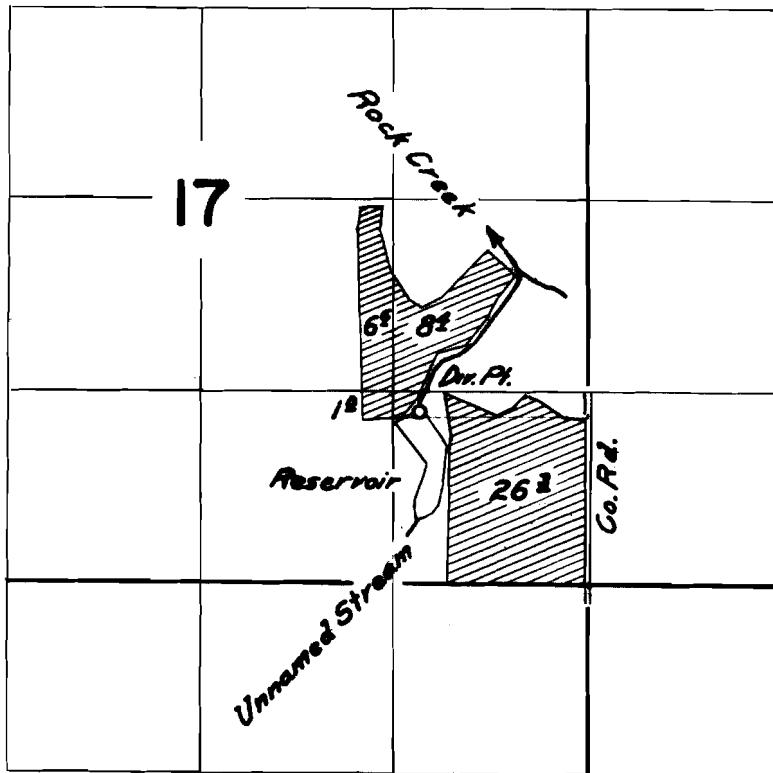

FINAL PROOF SURVEY UNDER

R-32328 *R-2144*
Application No. *32329* Permit No. *25528*
IN NAME OF

.....*John J. Schmitz*.....

Surveyed *May 14, 1962*, by *Thomas R. Lauer*