


T.4 & 5N.R.7W.W.M.

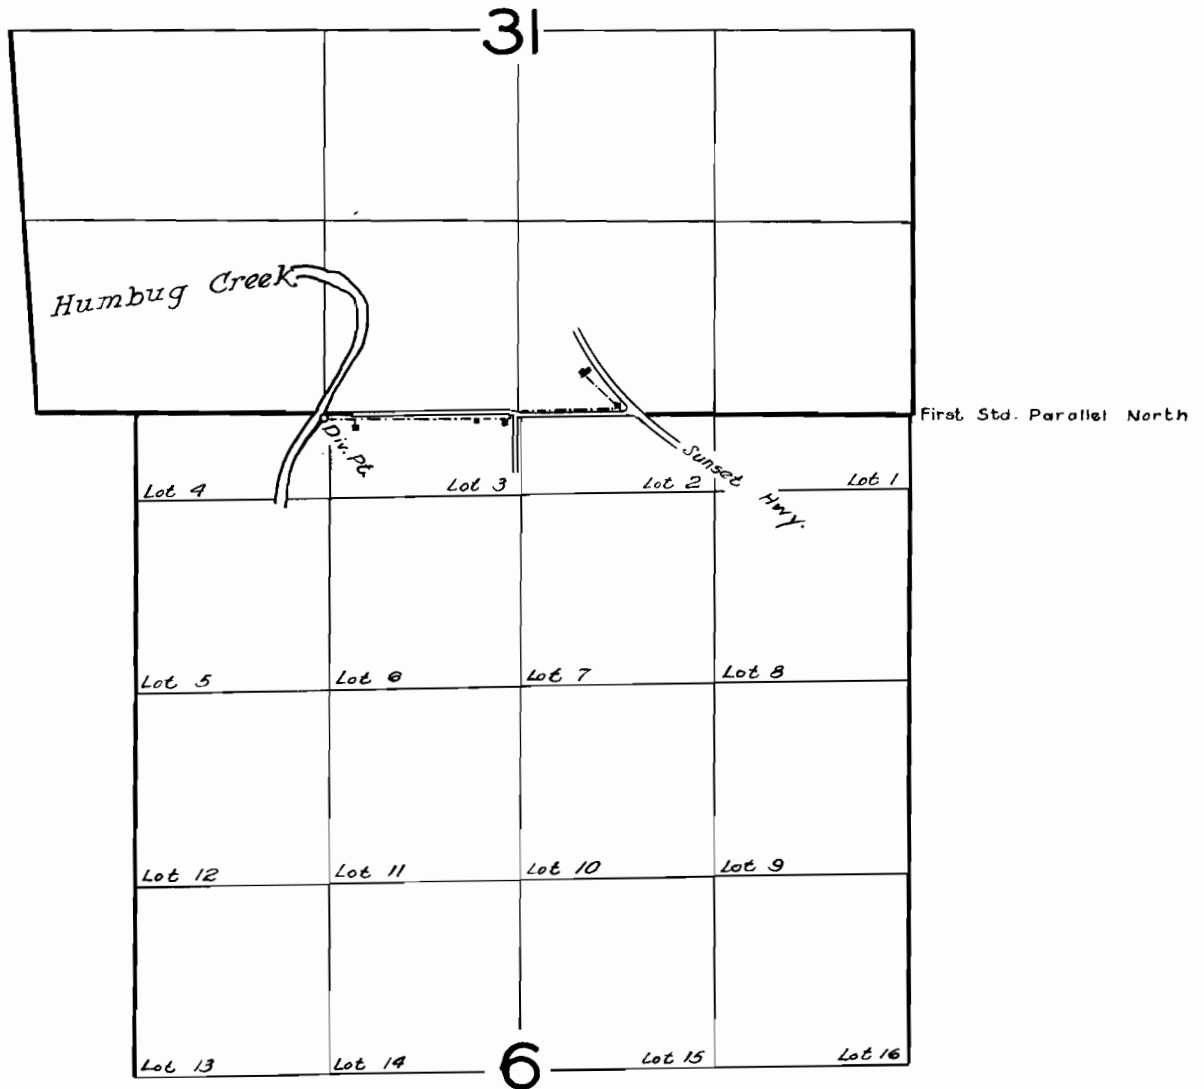

FINAL PROOF SURVEY
UNDER

Application No. **31683** Permit No. **24993**
IN NAME OF

FRED M. & DONNA J. LARSON

Surveyed July 9, 1962, by *R. Johnson*