


T.30S.R.4W.W.M.

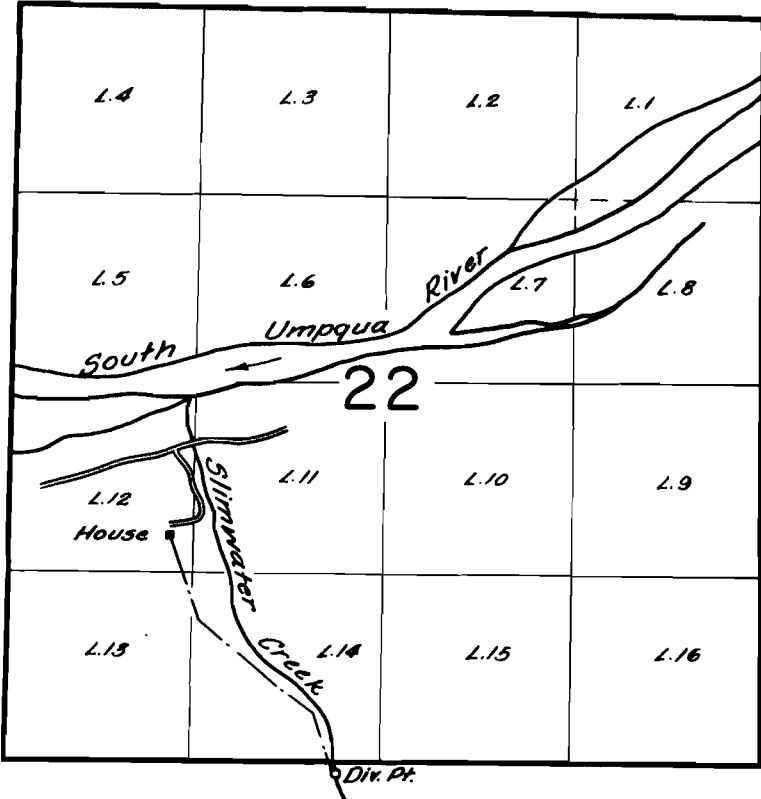

FINAL PROOF SURVEY
UNDER

Application No. 30313 Permit No. 24362
IN NAME OF

A.M. & Elsie M. Rowe

Surveyed April 11, 1963, by C. O. Bartels