


T. 27S. R. 4W. W.M.

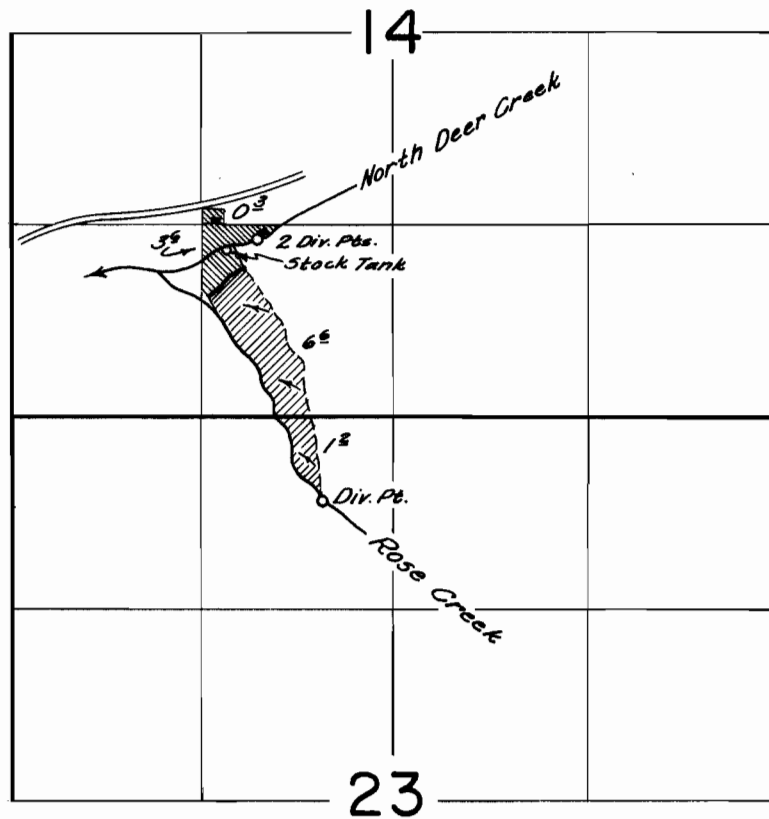

FINAL PROOF SURVEY
UNDER

Application No. 37873 Permit No. 28226....
IN NAME OF

Raymond E. Miller

Surveyed May 20 1963, by T. Lauer.....