


T.27S. R.4W. W.M.

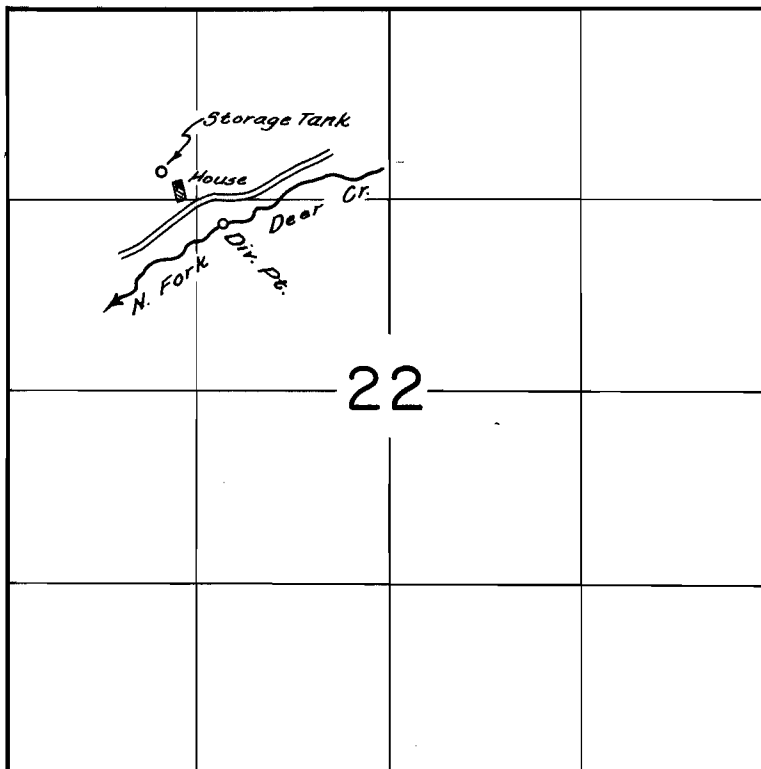

FINAL PROOF SURVEY
UNDER

Application No. 38061 Permit No. 28393
IN NAME OF

Nick Evanoff

Surveyed May 20 1963, by J. Lauer