


# T.9S.R.27E.W.M.

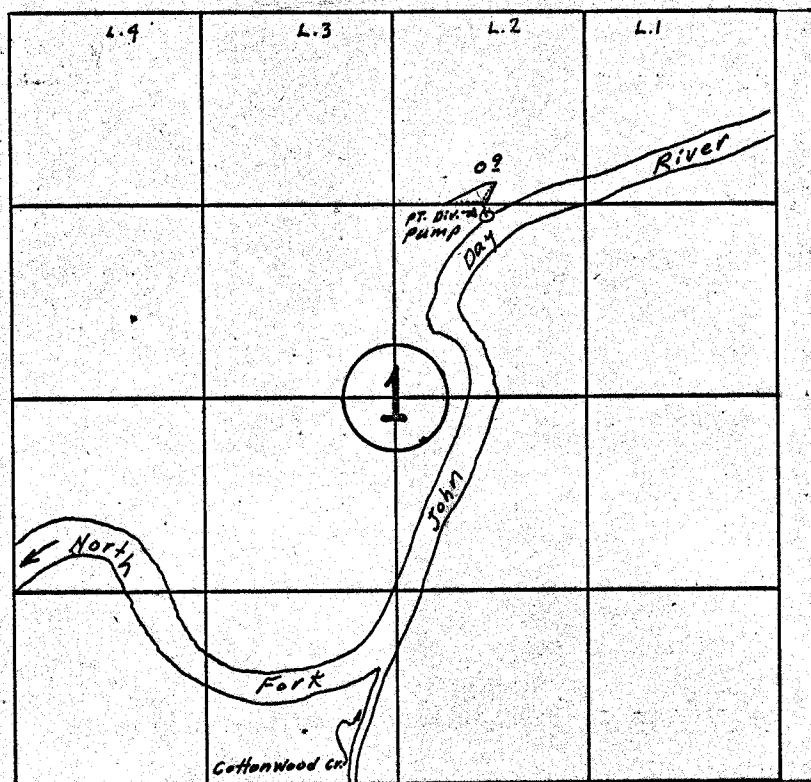

## FINAL PROOF SURVEY UNDER

Application No. 32834 Permit No. 25941

IN NAME OF

Fred F. McWillis

Surveyed Jan 15 1964 by G. Ward