


T.36S. R.1E. W.M.

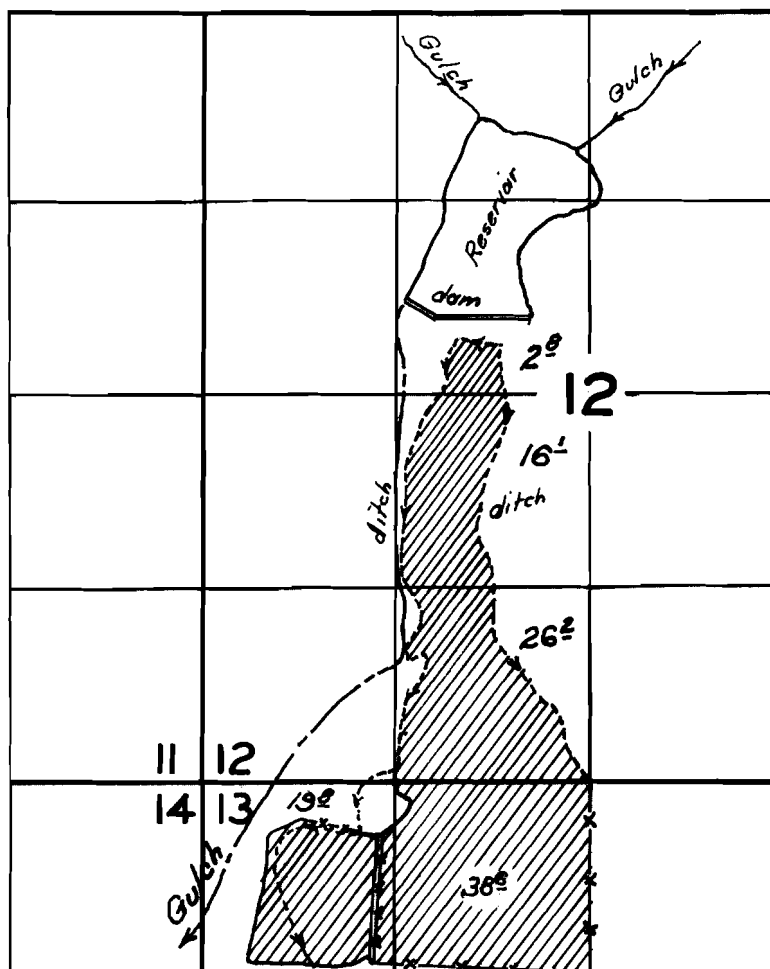

FINAL PROOF SURVEY
UNDER

R-27335 R-1460
Application No. 32852 Permit No. 25951
IN NAME OF

Charles Stanley

Surveyed 13 April 1962, by Carl R. Baker