


T.35 S. R.1 W.W.M.

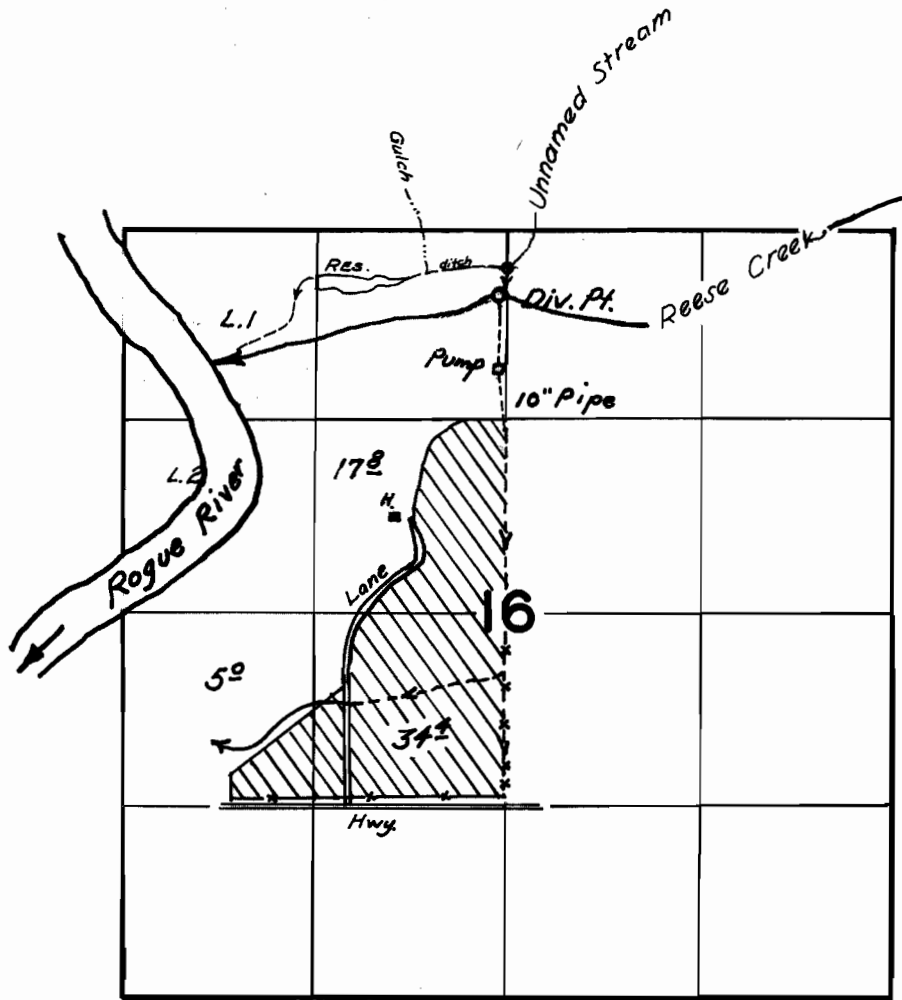

**FINAL PROOF SURVEY**  
UNDER

Application No. 32808 Permit No. 26054  
IN NAME OF

Margaret Grey Gizzi

Surveyed 13 April 1962, by Carl R. Baker