


TWP 33 S R5WWM.

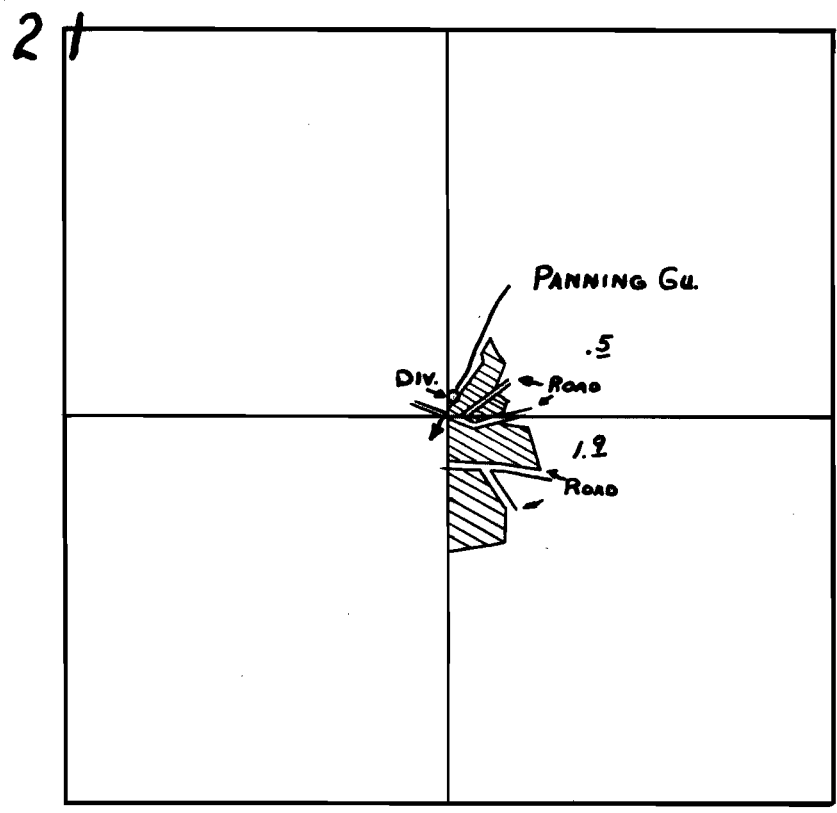

SE  $\frac{1}{4}$  SEC 21

RECEIVED

**FINAL PROOF SURVEY**  
UNDER

Application No. 34953 Permit No. 27412  
IN NAME OF

HENRY AND IDA I HERMAN

Surveyed 6-14 1963, by R STEIMER