


T. 38S. R. 11 $\frac{1}{2}$ & 11E. W.M.

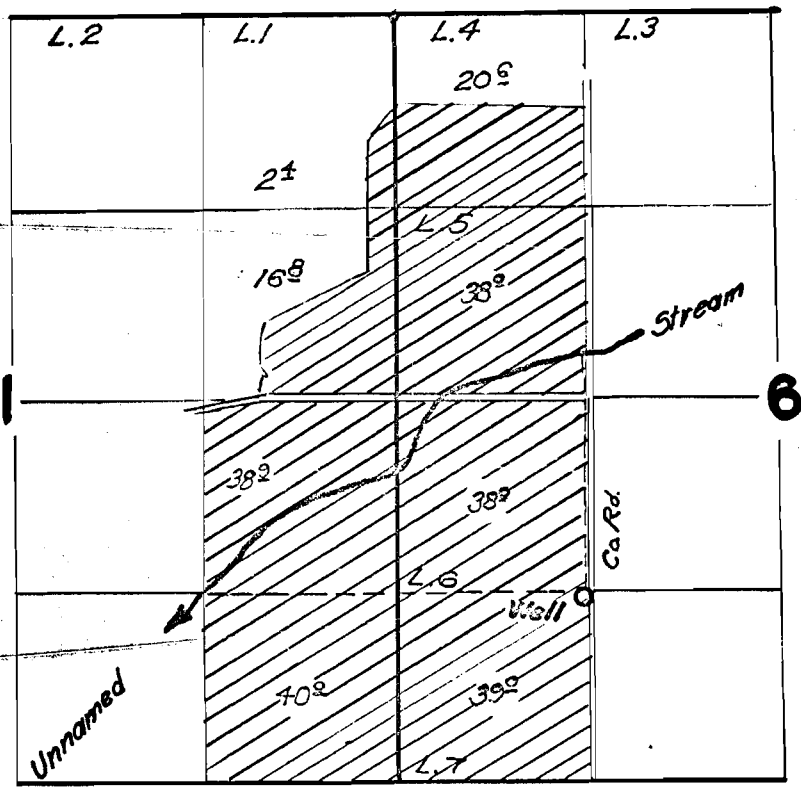

Back of game valley weeds

FINAL PROOF SURVEY UNDER

Application No. U-245 Permit No. U-219
IN NAME OF

J. P. Colahan

Surveyed 15 Aug. 1962, by Carl R. Baker