


31456

T.29 & 30 S. R. 17 E. W.M.

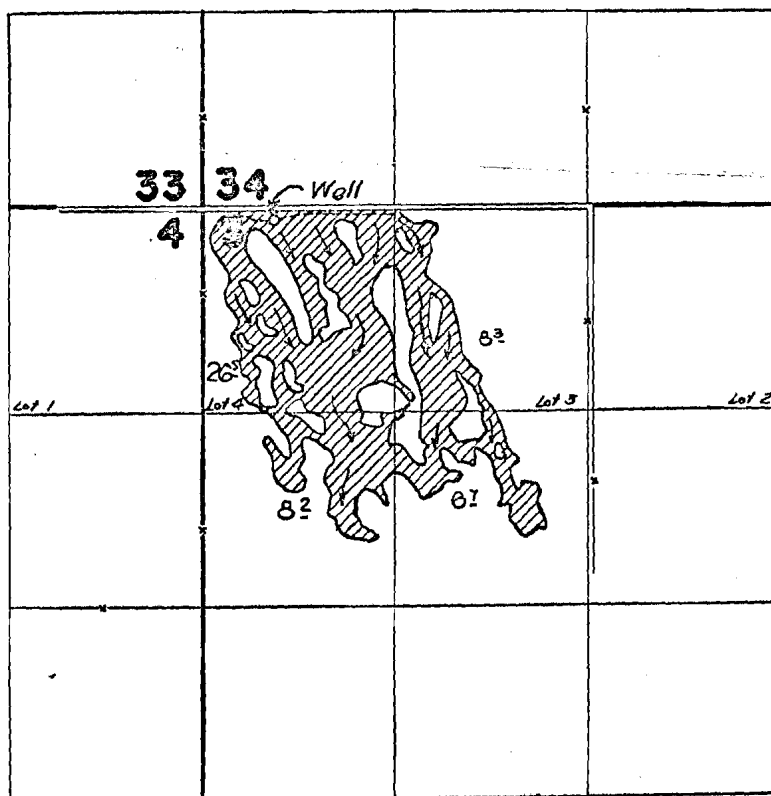

FINAL PROOF SURVEY
UNDER

Application No. G-56... Permit No. G-117...
IN NAME OF

BELLE MORGAN

May 14 1959 M. Blish
Surveyed Sept. 20. 1962, by R. Jackson.....