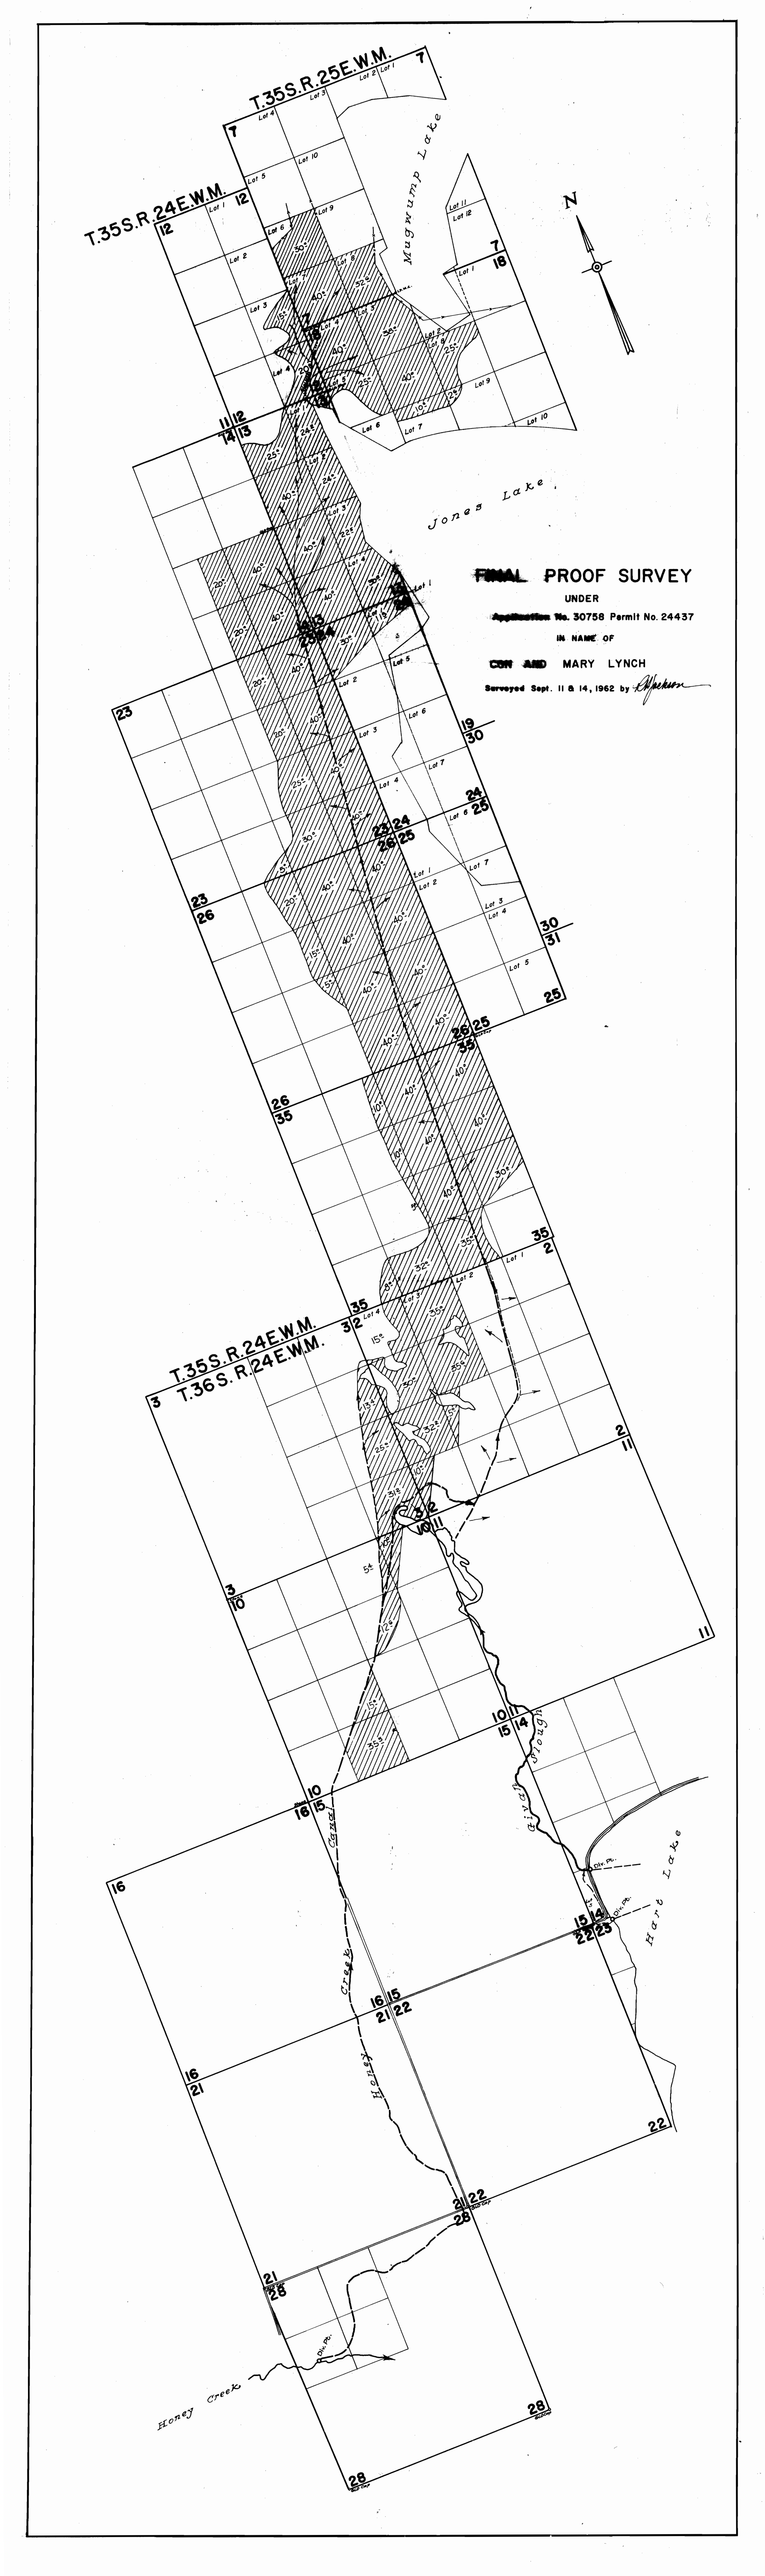
T.35S.R.25E.W.M.
T.35S.R.24E.W.M.
T.35S.R.24E.W.M.
T.36S.R.24E.W.M.
Mugwump Lake
Jones Lake
Hart Lake
Honey Creek
N
FINAL PROOF SURVEY
UNDER
Application No. 30758 Permit No. 24437
IN NAME OF
CON AND MARY LYNCH
Surveyed Sept. 11 & 14, 1962 by