


T.18 S. R. 2 W. W.M.

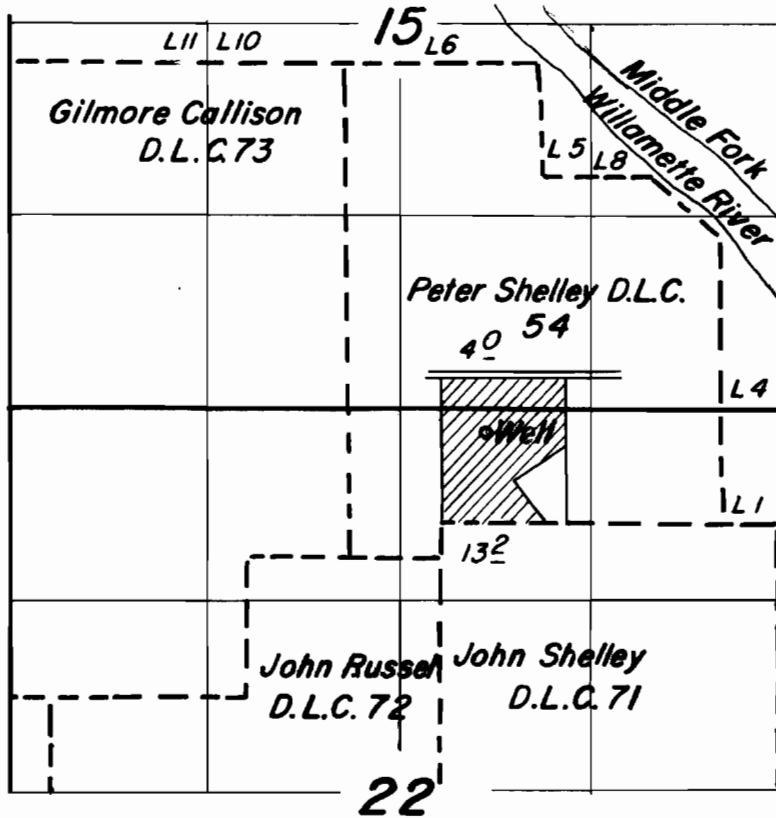

**FINAL PROOF SURVEY
UNDER**

Application No. G-1719 Permit No. G-1576
IN NAME OF

A.W. Brown

Surveyed May 7 1963 by Tom Lauer