


T. 18 S. R. 2 W. W.M.

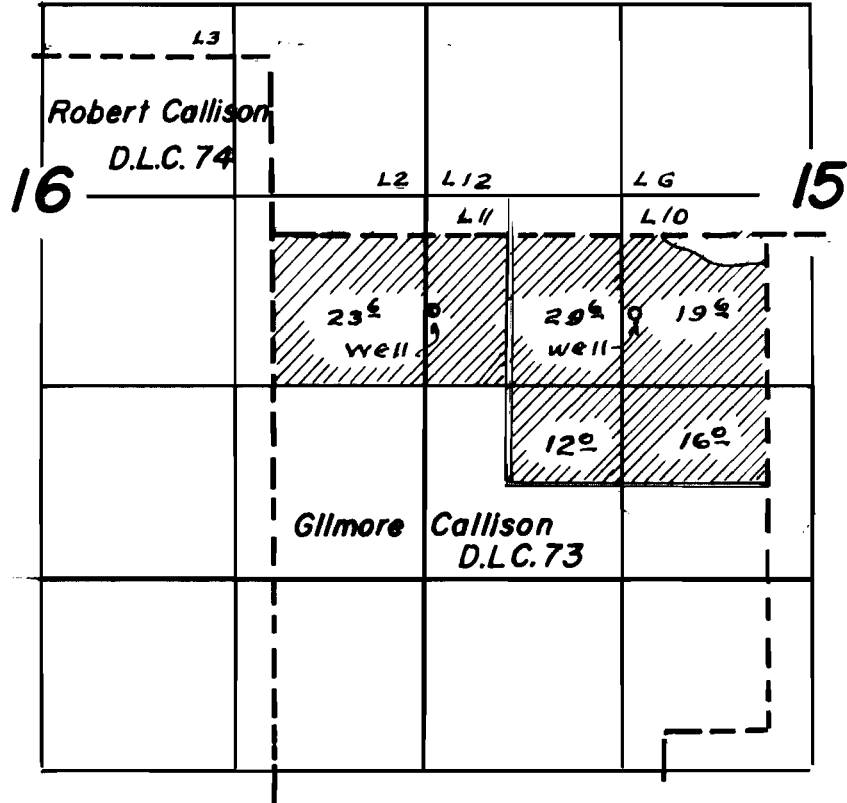

FINAL PROOF SURVEY
UNDER

Application No. G-1766 Permit No. G-1618
IN NAME OF

Rodney Chase

Surveyed May 7 1963, by T. Lauer