


T. 16 S. R. 3 W. W. M

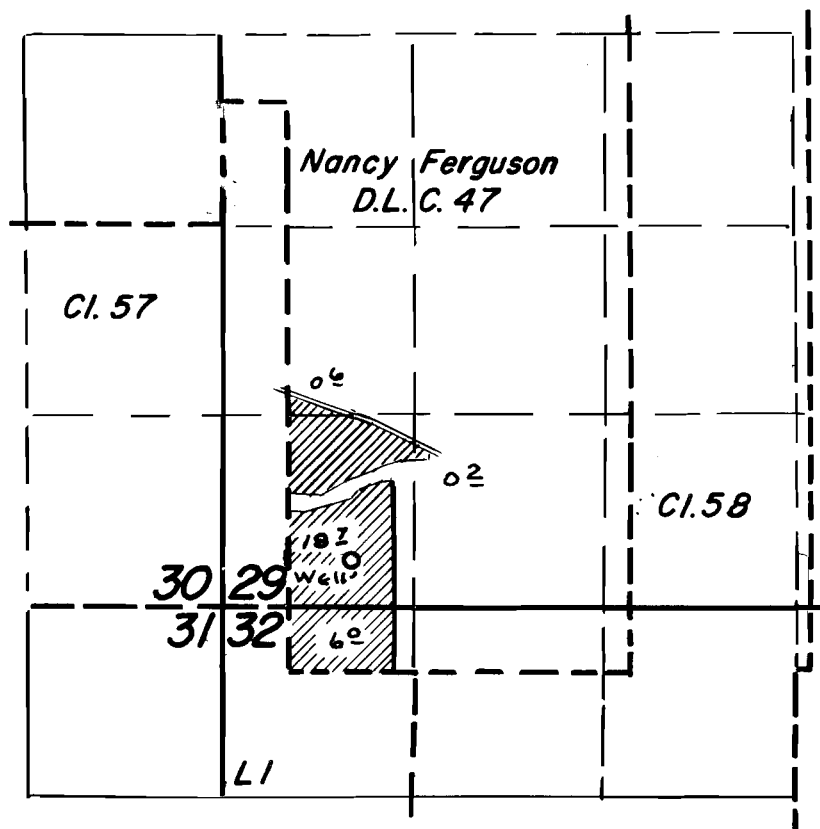

FINAL PROOF SURVEY
UNDER

Application No. G-1943 Permit No. G-1786
IN NAME OF

Morris E. Funke

Surveyed June 24 1963, by T. Lauer