


T.16 S.R.4 W.W.M.

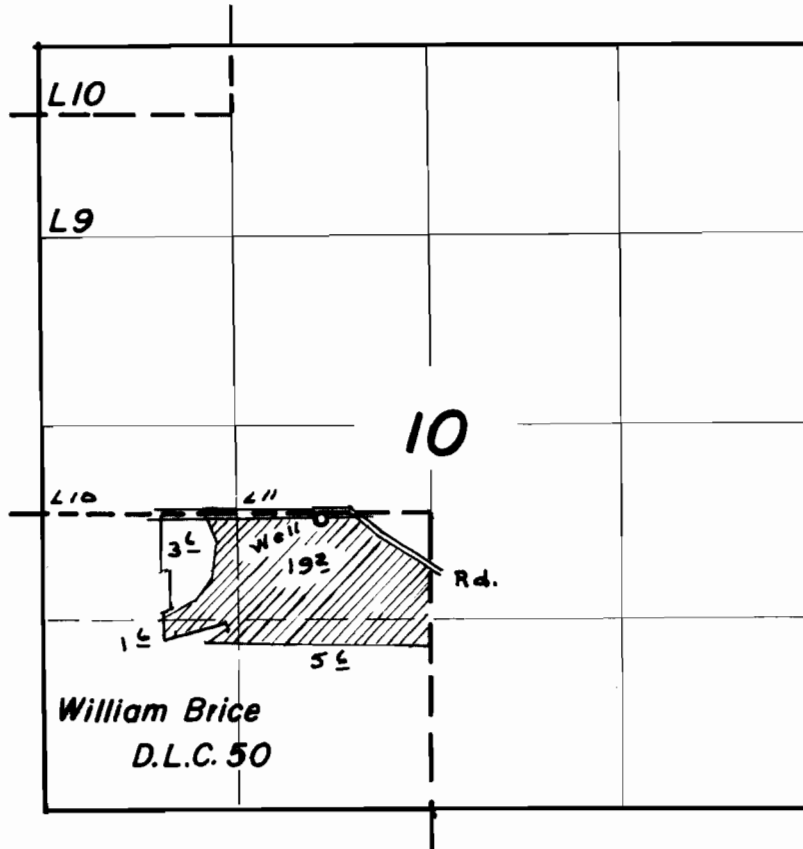

FINAL PROOF SURVEY
UNDER

Application No. *G-2206* Permit No. *G-2096*
IN NAME OF

Thomas J. Harper

Surveyed *June 19, 1963*, by *T. Lauer*