


T.16 S. R. 6 W. W. M.

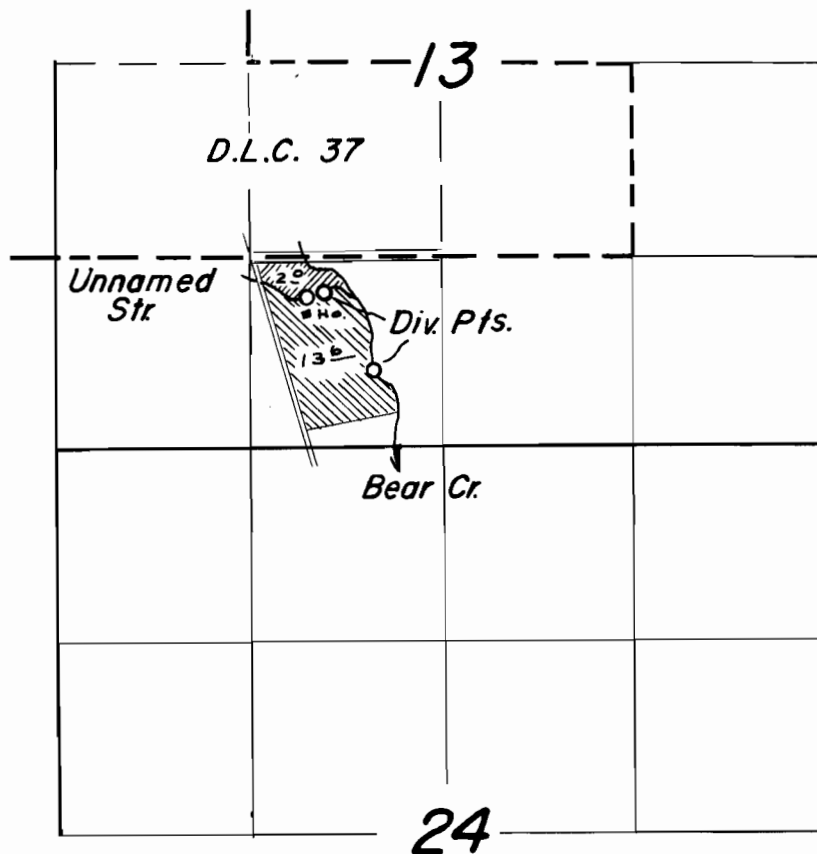

FINAL PROOF SURVEY
UNDER

Application No. 32397 Permit No. 25669
IN NAME OF

Lee A. Johnson

Surveyed June 20 1963, by T. Lauer