


T.16S.R.4E.W.M.

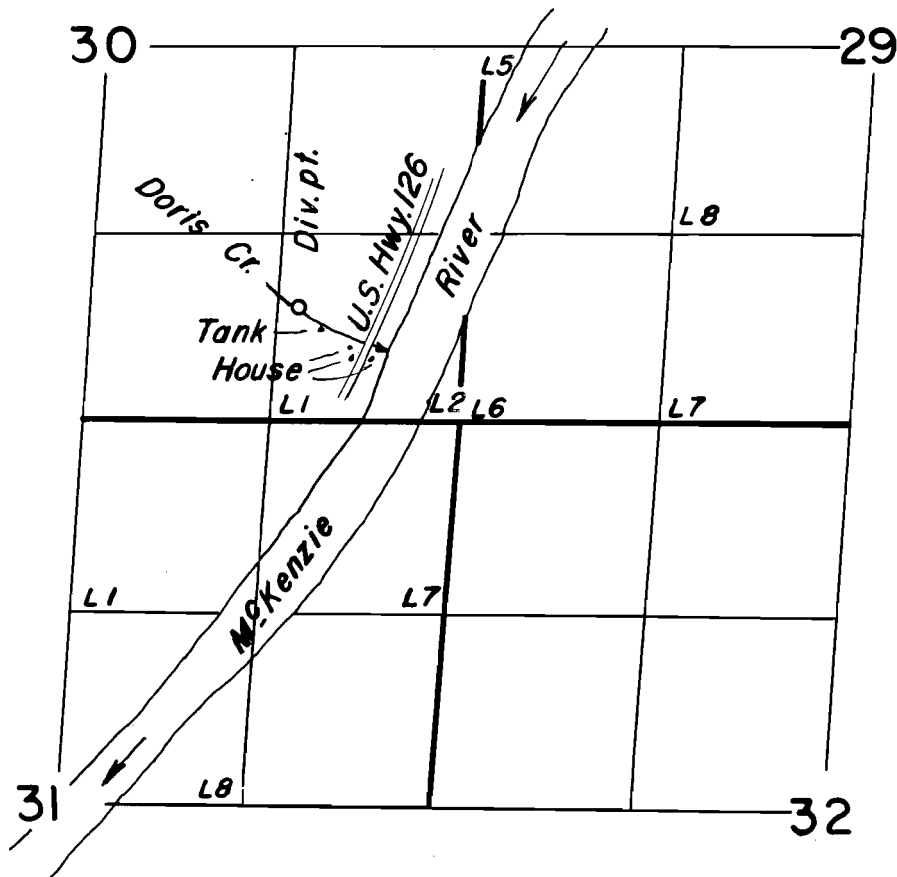

FINAL PROOF SURVEY
UNDER

Application No. 32708 Permit No. 25994
IN NAME OF

Stanley C. Brown.....

Surveyed June 18, 1963, by C. Baker.....