


T. 18 S. R. 2 W. W. M

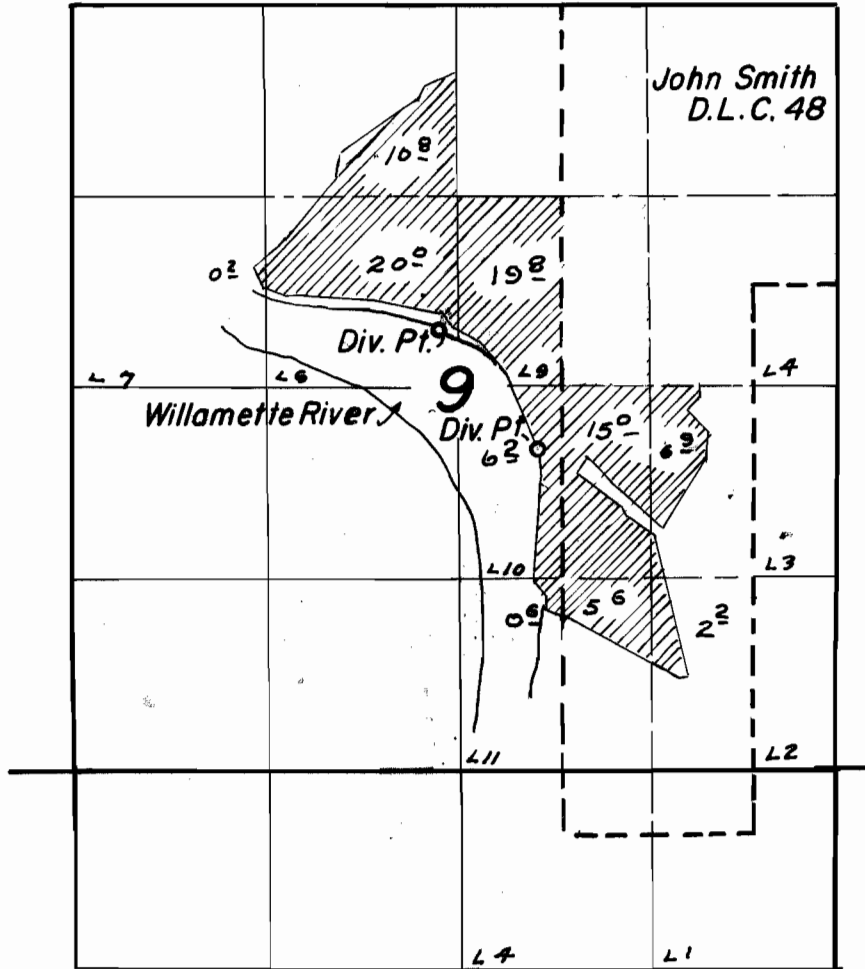

FINAL PROOF SURVEY
UNDER

Application No. 33222 Permit No. 26264
IN NAME OF

Don Hendricks

Surveyed May 10, 1963, by T. Lauer