


T.16S.R.6W.W.M.

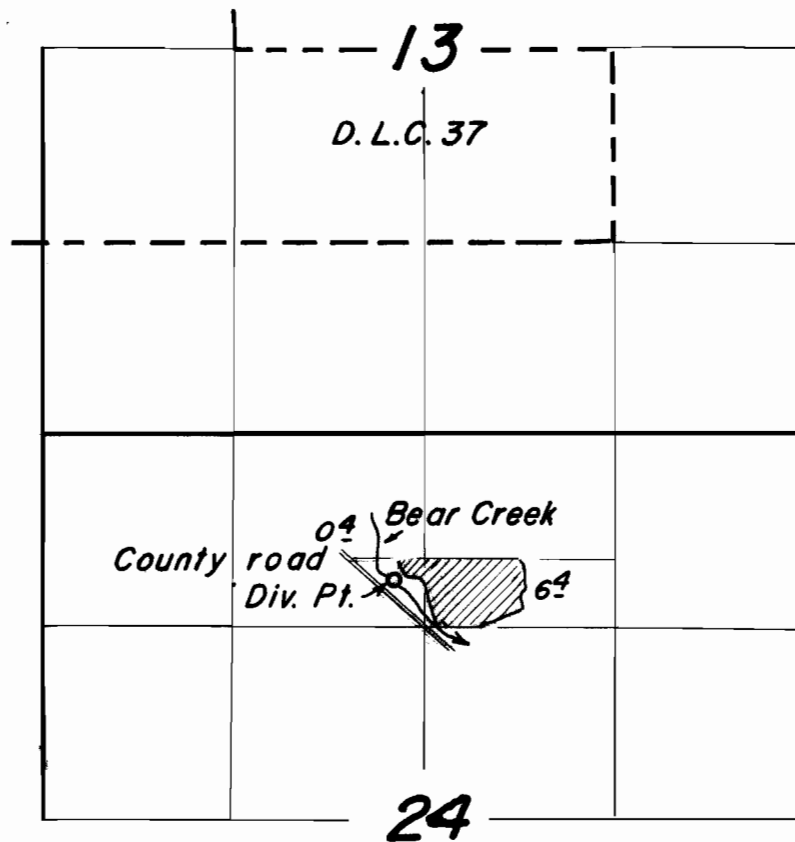

FINAL PROOF SURVEY
UNDER

Application No. 33226 Permit No. 26278
IN NAME OF

Vivian M. Leuthoed

Surveyed June 17 1963 by Tom Lauer