


T. 17S. R. 7 W. W.M.

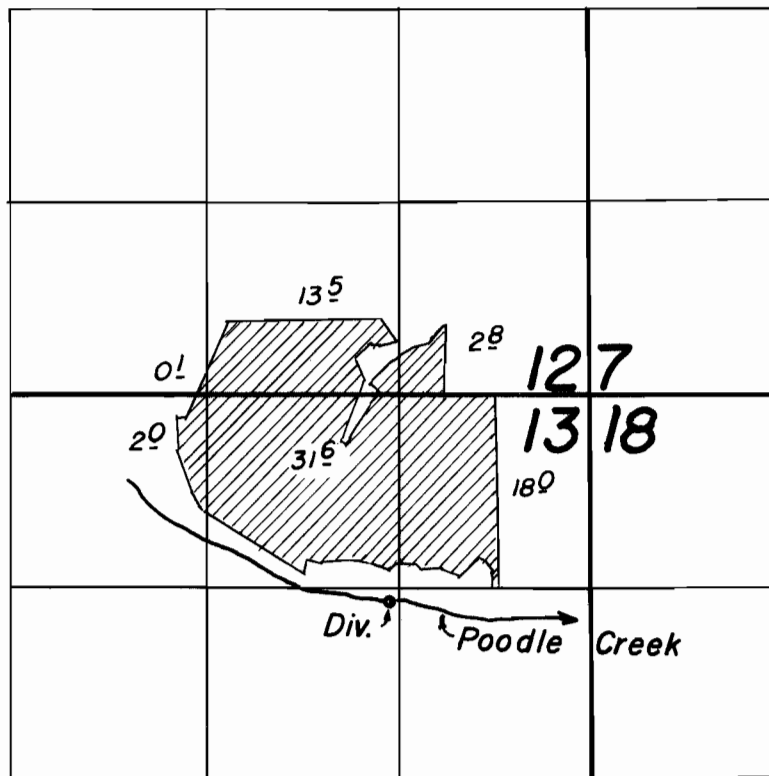

**FINAL PROOF SURVEY
UNDER**

Application No. 33523 Permit No. 26512
IN NAME OF

Roy E. & Beulah E. McTavish

Surveyed June 19 1963, by C. Baker