


T. 19 S. R. 1 W. W. M.

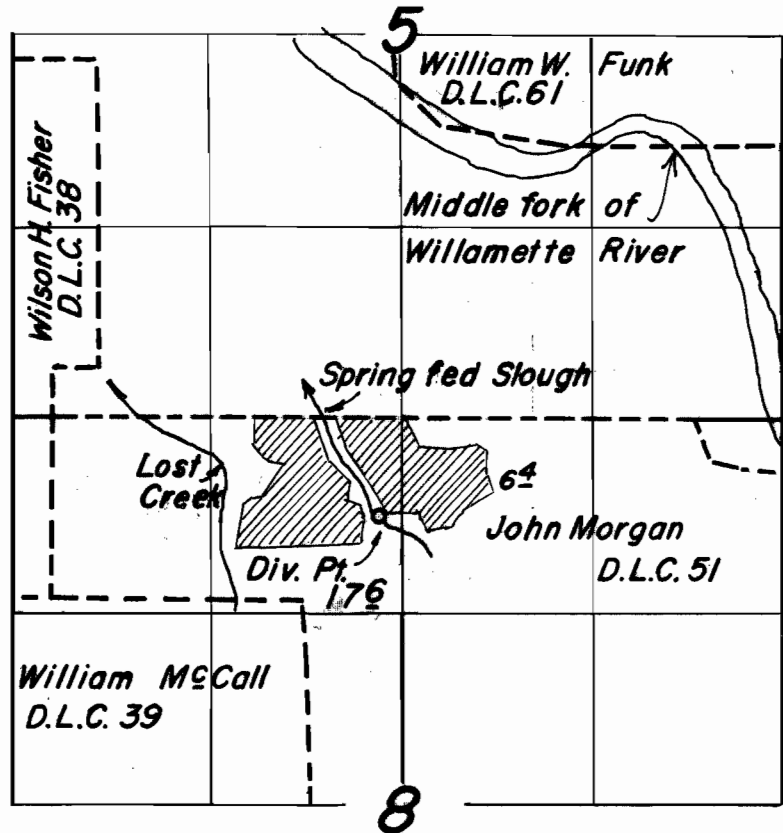

FINAL PROOF SURVEY
UNDER

Application No. 33707 Permit No. 26601
IN NAME OF

Jess M. Larison

Surveyed June 20 1963, by C. Baker