


**T. 16 S. R. 4 E. W. M.**

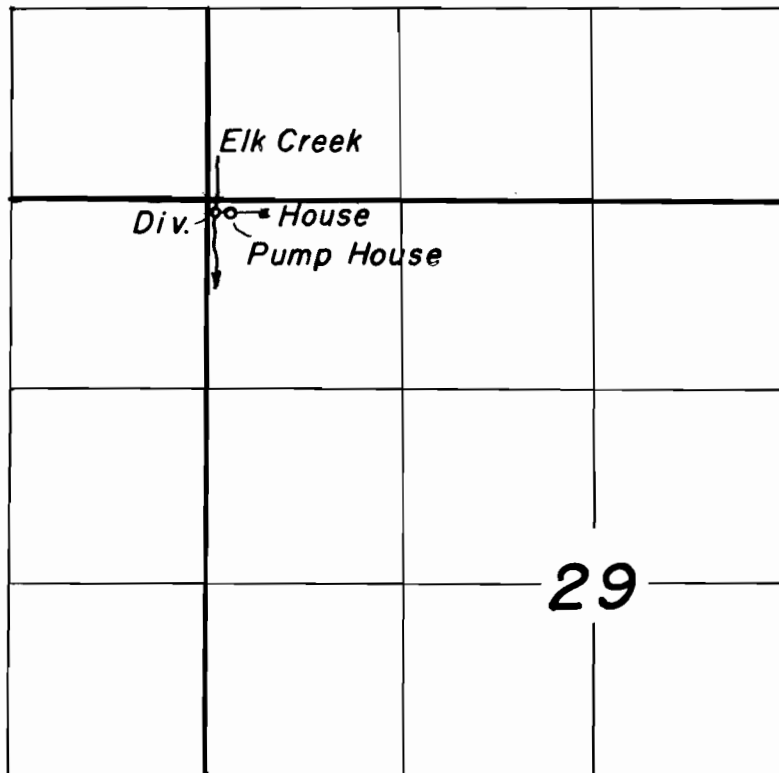

**FINAL PROOF SURVEY**  
UNDER

Application No. 34871 Permit No. 27369  
IN NAME OF

Richard D. & Ann H. Chandler

Surveyed June 18 1963 by C. Baker