


T. 19 S. R. 3 W. W. M.

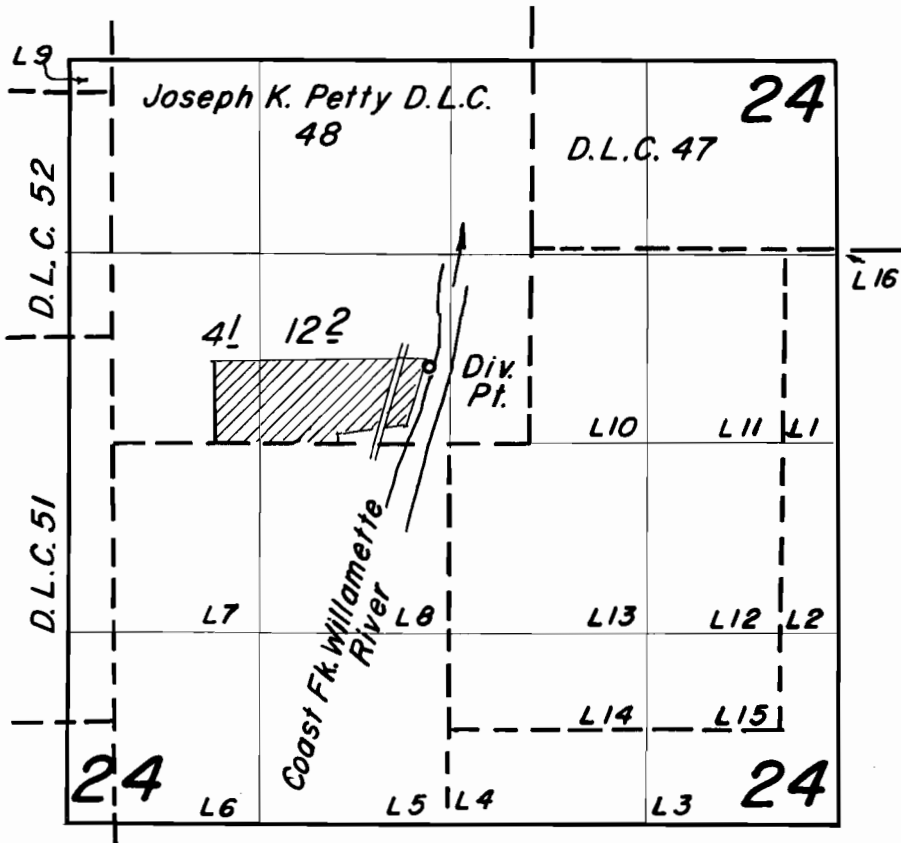

FINAL PROOF SURVEY
UNDER

Application No. 34964 Permit No. 27421
IN NAME OF

Leland Z. Heart

Surveyed May 7 1963, by Tom Lauer