


T. 19 S. R. 1 W. W. M.

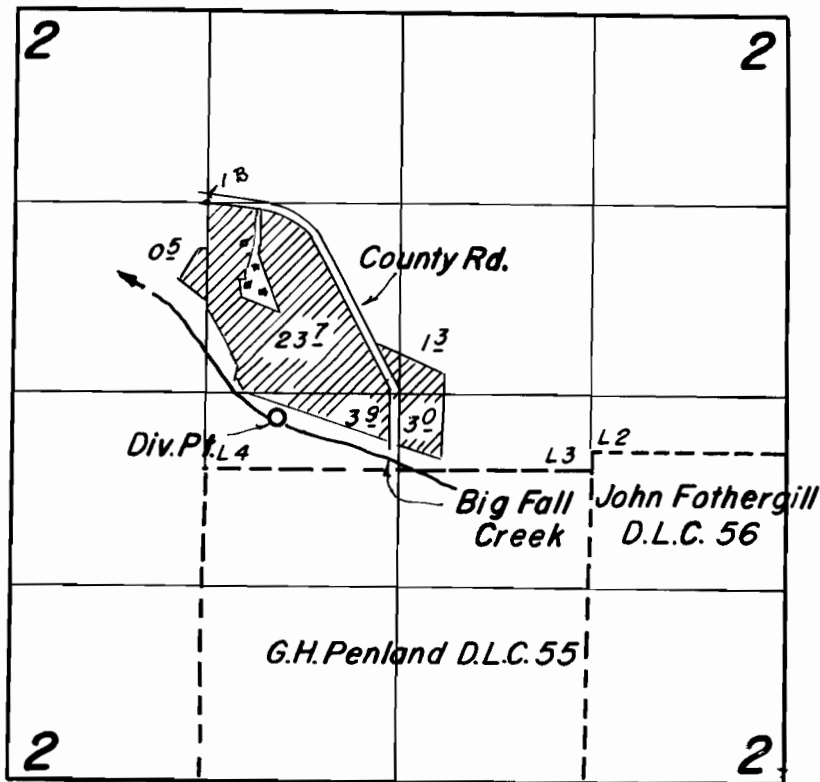

FINAL PROOF SURVEY
UNDER

Application No. 37398 Permit No. 27856
IN NAME OF

John D. Duncan

Surveyed March 13 1963, by Floyd L. Siegmund