


T. 19 S. R. 1 E. W. M.

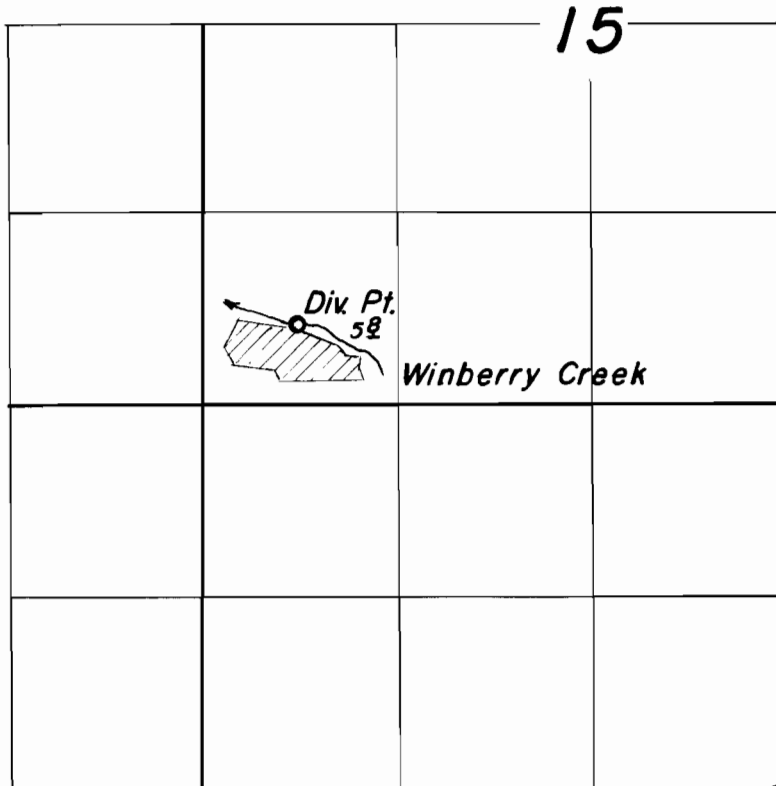

FINAL PROOF SURVEY
UNDER

Application No. *37664* Permit No. *28074*
IN NAME OF

Paul Wysong

Surveyed *May 9* 1963, by *T. Lauer*