


T. 19 S. R. 1 W. W. M.

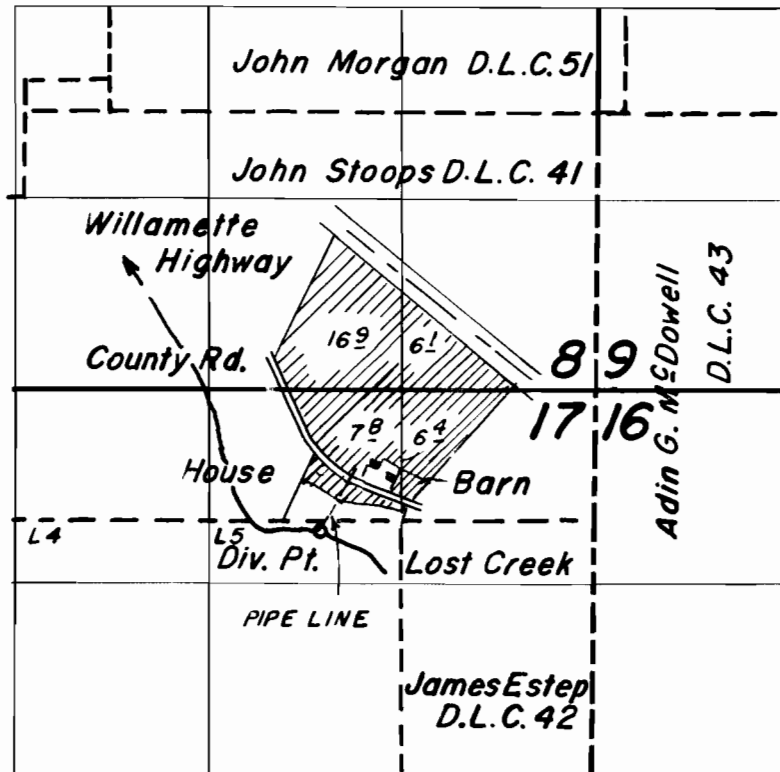

FINAL PROOF SURVEY
UNDER

Application No. **37676** Permit No. **28080**
IN NAME OF

Richard E. Cone

Surveyed **March 13 1963**, by *Floyd L. Siegmund*