


T. 16 S. R. 6 W. W. M.

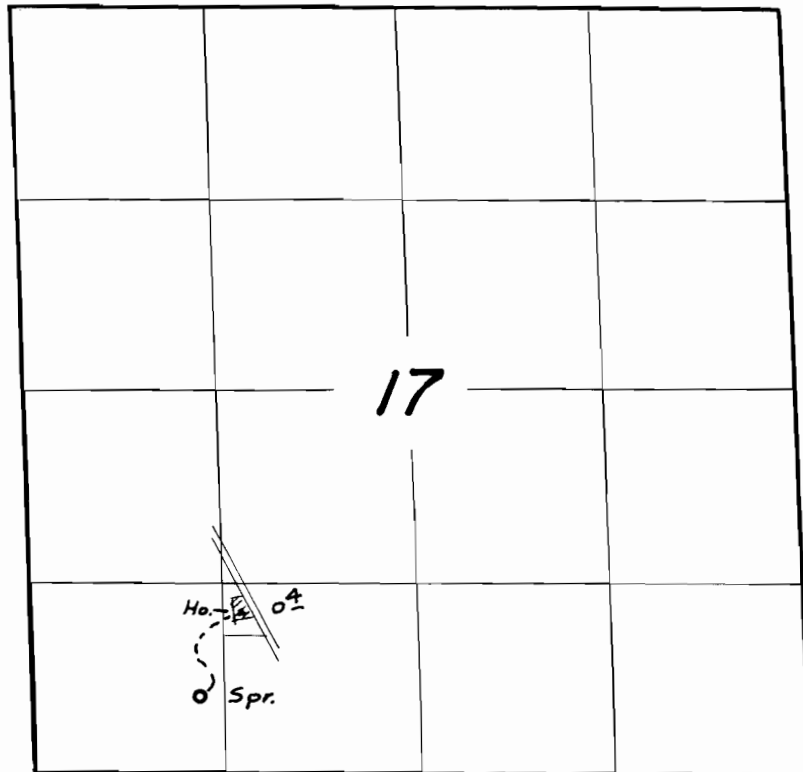

FINAL PROOF SURVEY
UNDER

Application No. 37812 Permit No. 28159
IN NAME OF

Harold R. & Margaret M. Aumiller

Surveyed June 19 1963, by T. Lauer