


T.12 S.R.11&12 W.W.M.

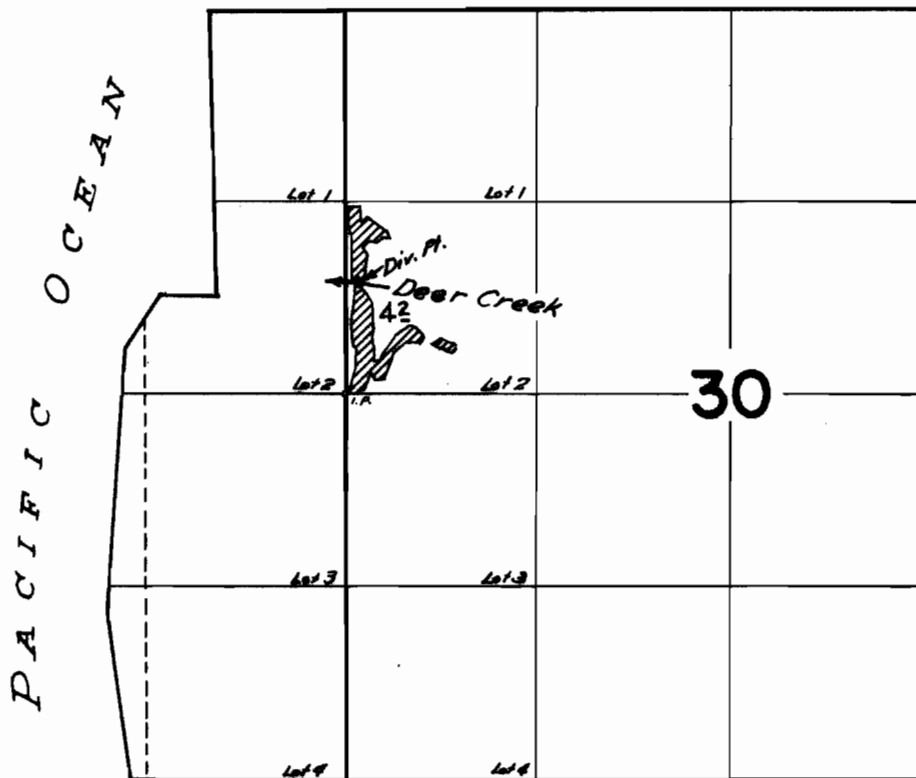

FINAL PROOF SURVEY
UNDER

Application No. 29391 Permit No. 23153
IN NAME OF

STANLEY O. LEVACK

Surveyed June 28, 1962, by

R. H. Jackson