


T. 6 S.R. 11 W.W.M.

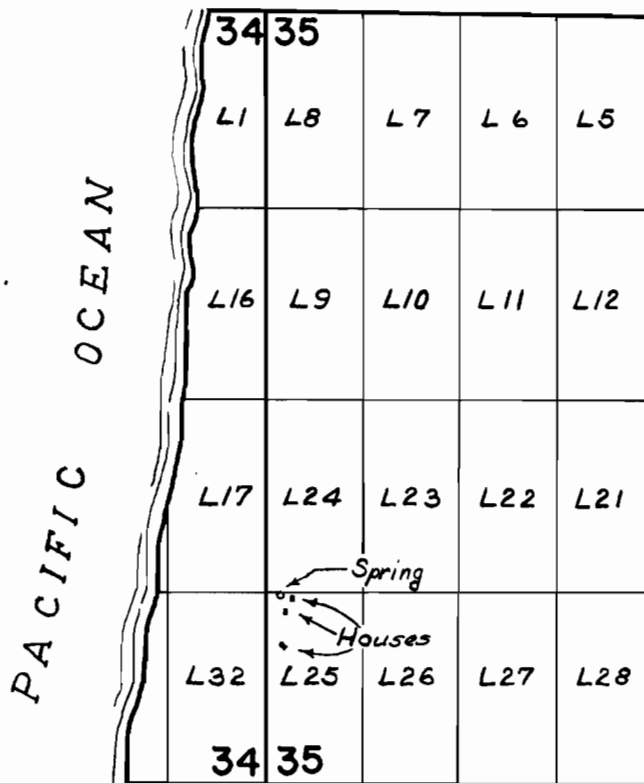

FINAL PROOF SURVEY UNDER

Application No. 34974 Permit No. 27428
IN NAME OF

A.E. GUENTHER & HAZEL DUNLAP

Surveyed June 26 1962, by C.R. Baker