


T. 12 S. R. 1 W. W.M.

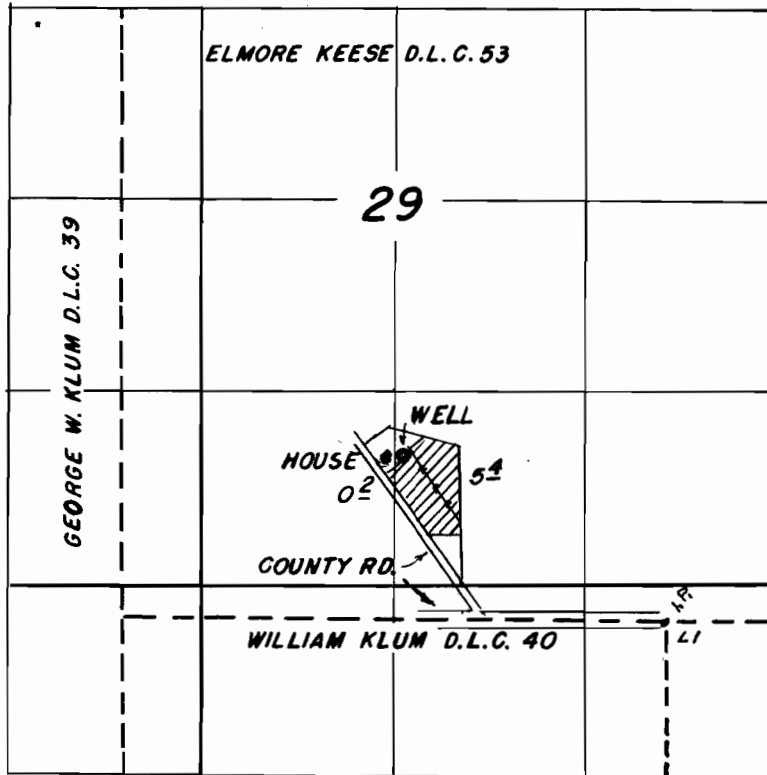

**FINAL PROOF SURVEY**  
UNDER

Application No. G-1358 Permit No. G-1228  
IN NAME OF

William S. & Mildred M. West

Surveyed Feb. 11 1963, by Floyd L. Siegmund