


T. 9 S. R. 2 W. W. M.

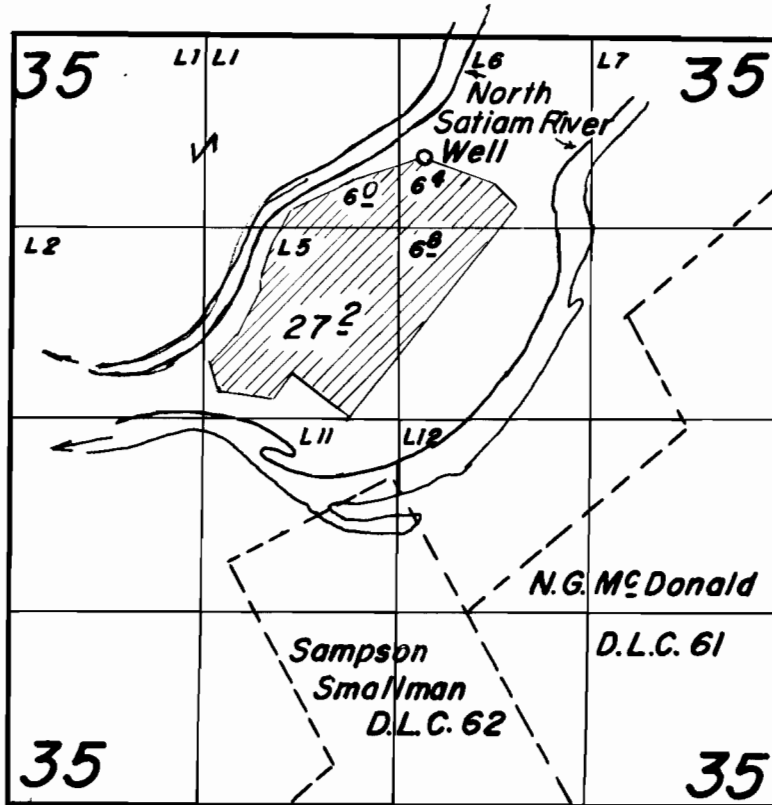

**FINAL PROOF SURVEY**  
UNDER

Application No. G 1747 Permit No. G 1598  
IN NAME OF

C.C. Gavette

Surveyed April 11 1963, by Floyd L. Siegmund