


T. 10 S. R. 4 W. W. M.

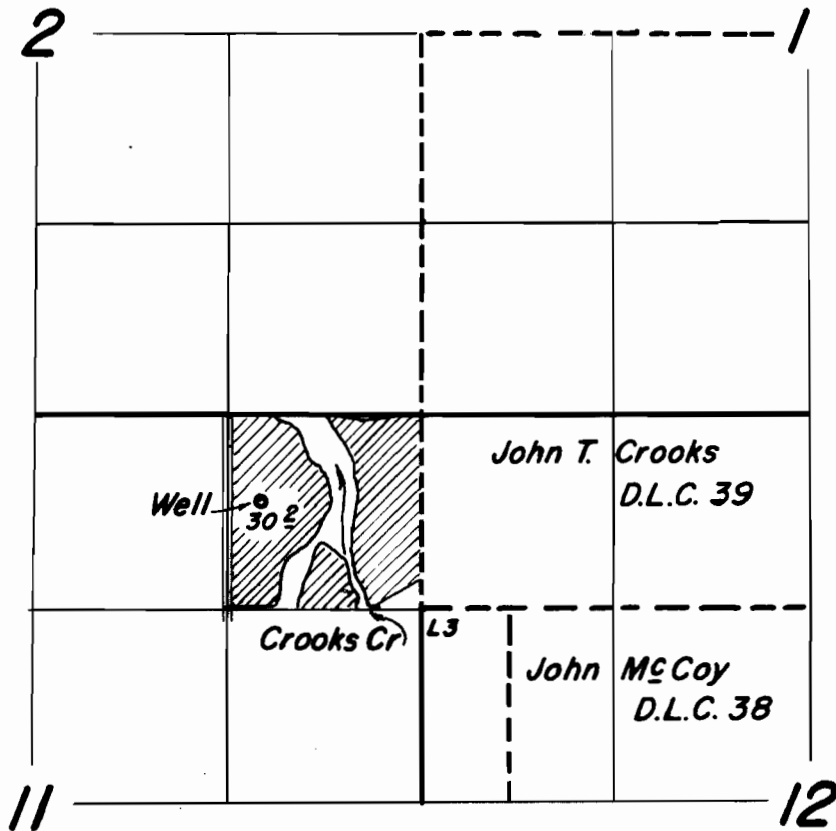

FINAL PROOF SURVEY
UNDER

Application No. *G-1808* Permit No. *G-1653*
IN NAME OF

Aden A. Chambers

Surveyed *March 20* 1963, by *Floyd L. Siegmund*