


T. 11 S. R. 4 W. W. M.

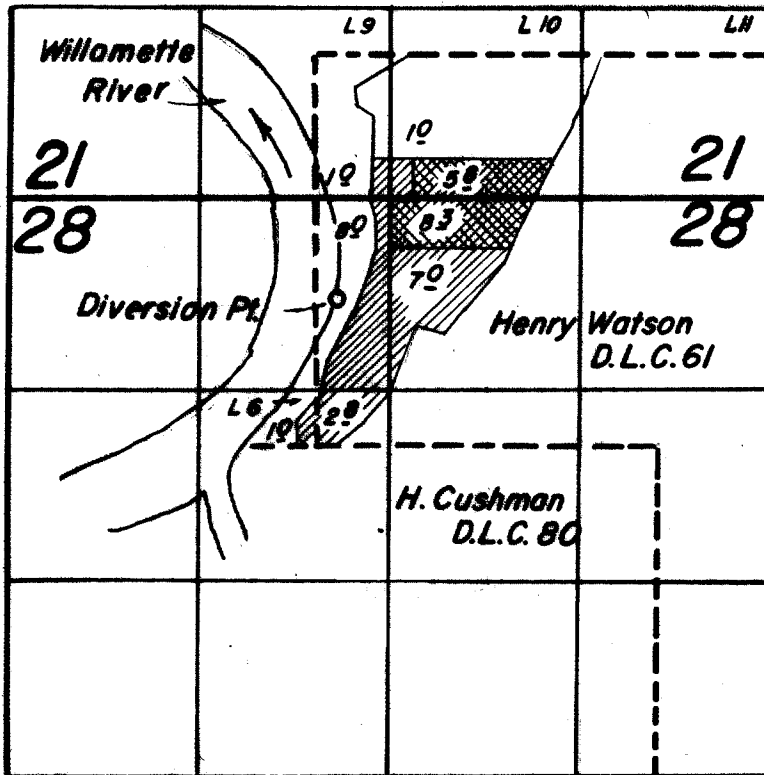

FINAL PROOF SURVEY
UNDER

 **Primary**

 **Supplemental**

Application No. 33566. Permit No. 26556
IN NAME OF

Edwin S. & Lois G. Norris

Surveyed April 9, 1963, by *Floyd L. Sigmund*