T. 11 S. R. 4 W. W. M.

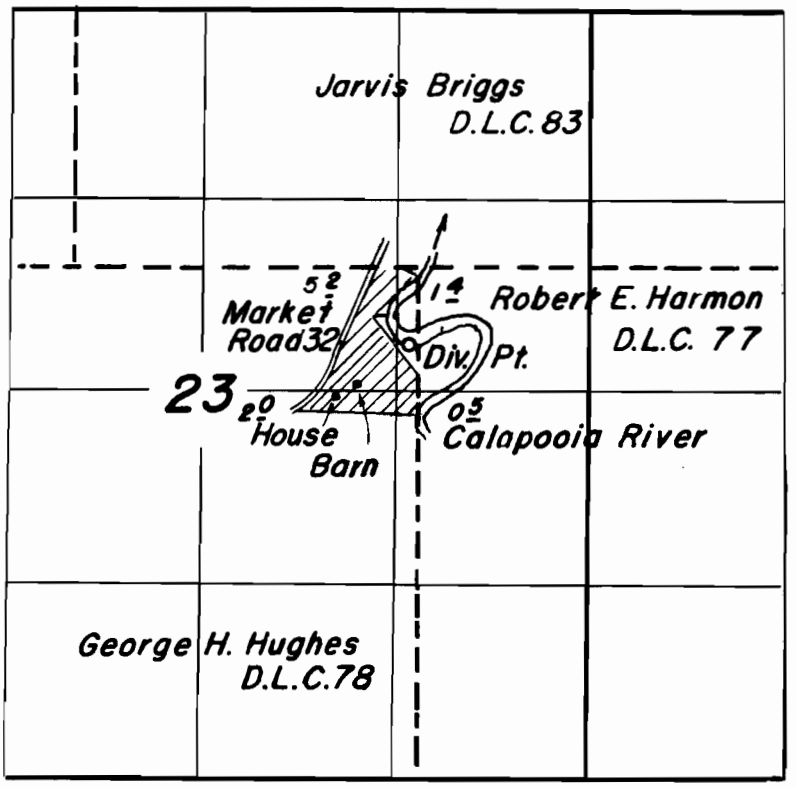

FINAL PROOF SURVEY

UNDER

Application No. 34138 Permit No. 26900

IN NAME OF

Clifford Dannen

Surveyed April 12 1963, by Floyd L. Siegmund

2-1963-A