


T.5S.R.2W.W.M.

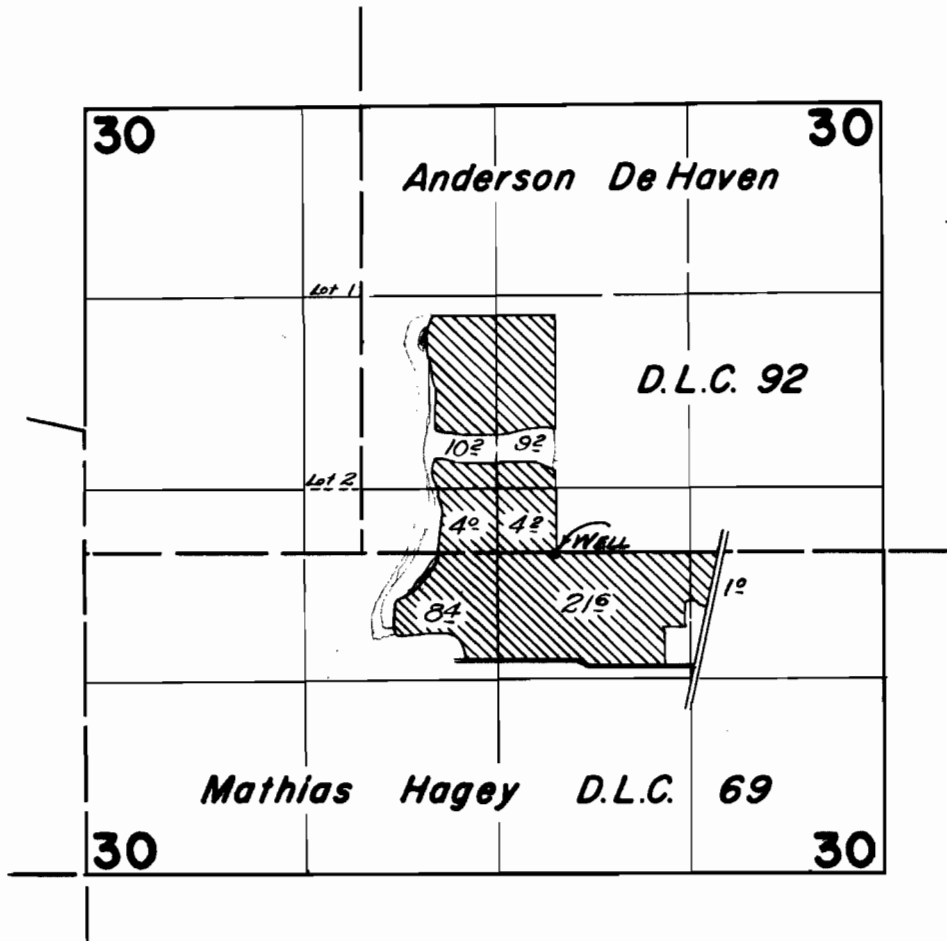

FINAL PROOF SURVEY UNDER

Application No. G-1499. Permit No. G-1372.
IN NAME OF

CARTER KEENE

Surveyed May 27 1963, by T. Lauer