


T.5 S. R. 2 W. W.M.

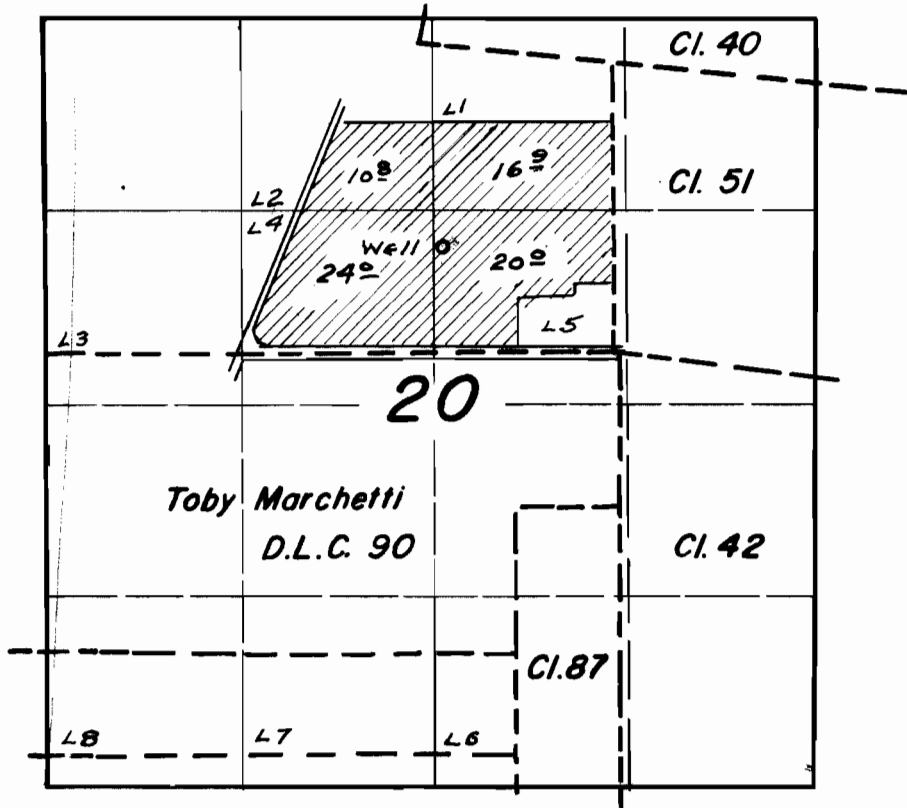

FINAL PROOF SURVEY
UNDER

Application No. ~~G-1744~~ Permit No. G-1595
IN NAME OF

Ernest Andres

Surveyed *May 27, 1963*, by *T. Lauer*