


**T. 7 S. R. 2 W. W.M.**

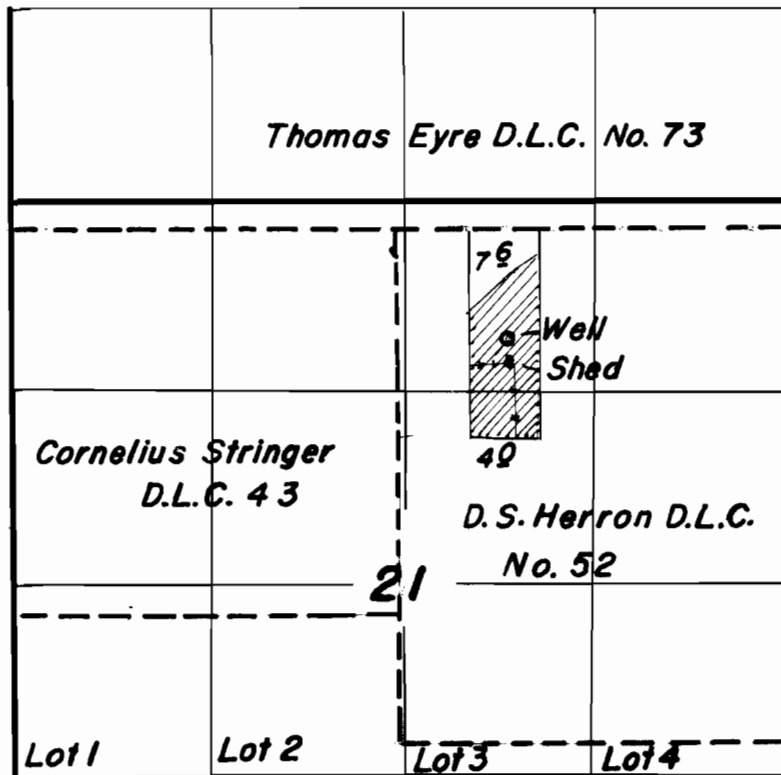

**FINAL PROOF SURVEY**  
UNDER

Application No. *G-1828* Permit No. *G-1668*  
IN NAME OF

*J. D. Campbell*

Surveyed *August 8* 1963, by *Floyd L. Sigmond*