


T. 6 S. R. 3 W. W. M.

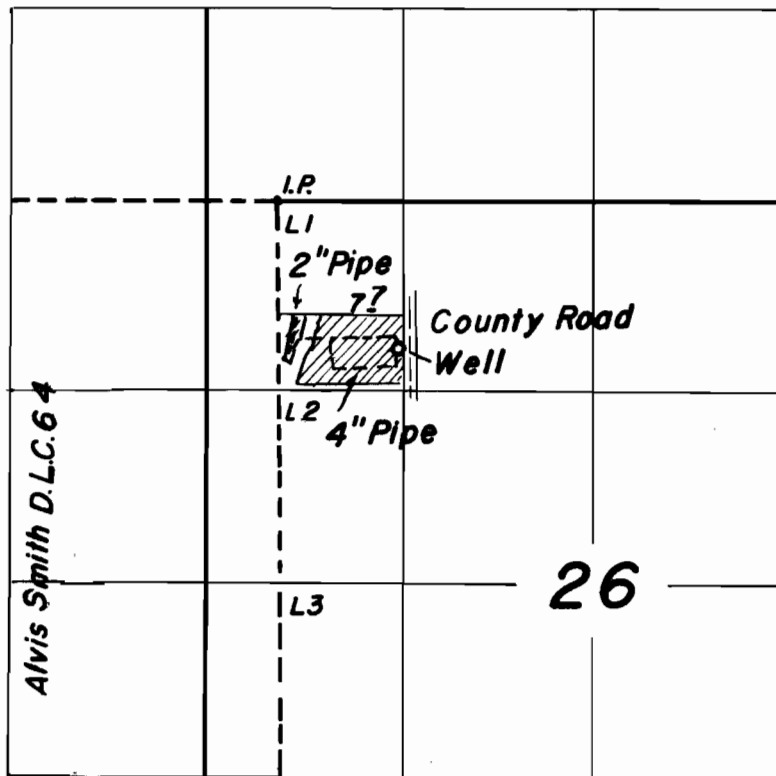

**FINAL PROOF SURVEY**  
UNDER

Application No. G-1858 Permit No. G-1700.  
IN NAME OF

Felix E. & Vivien Riedel

Surveyed Aug. 29, 1963, by Floyd L. Siegmund