


T.8 S.R. 3W. W.M.

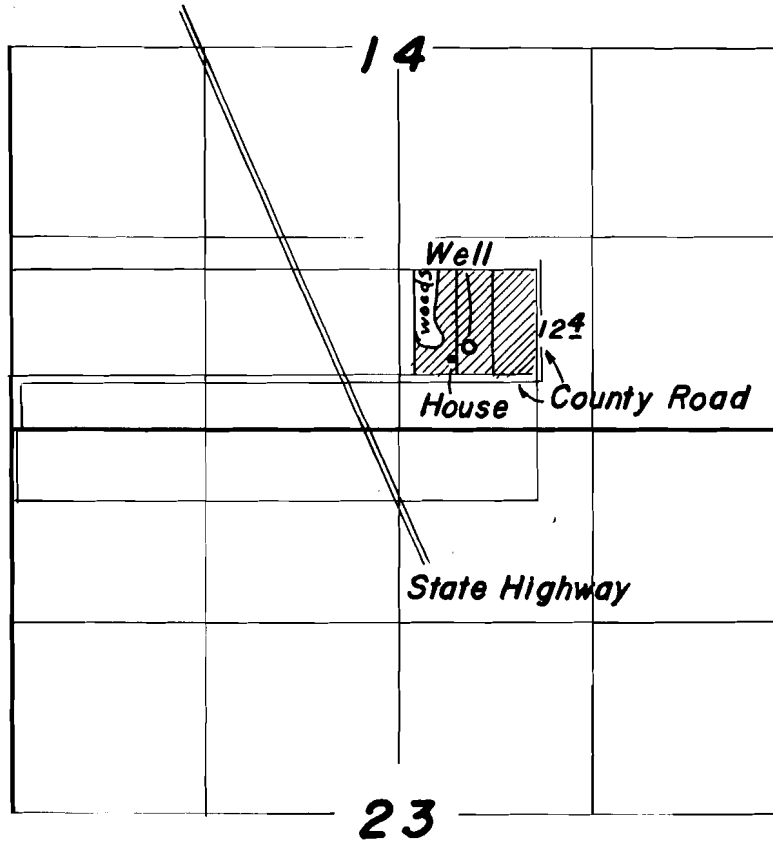

FINAL PROOF SURVEY
UNDER

Application No. G-2044 Permit No. G-1879
IN NAME OF

Kay C. Elling

Surveyed July 15 1963, by Floyd L. Sigmond