


T.7S.R.2W.W.M.

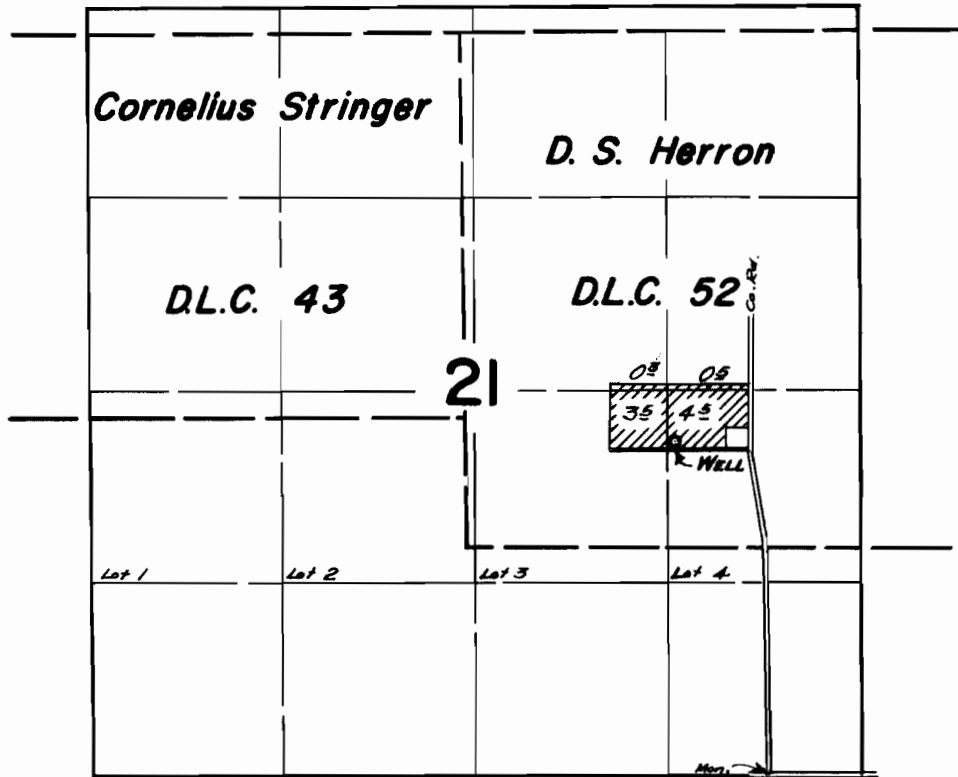

FINAL PROOF SURVEY UNDER

Application No. G-2176.. Permit No. G-2006
IN NAME OF

..... ROBERT FORDYCE

Surveyed August 201903., by Flayd L. Siegmund