


T. 6 S. R. 2 W. W. M.

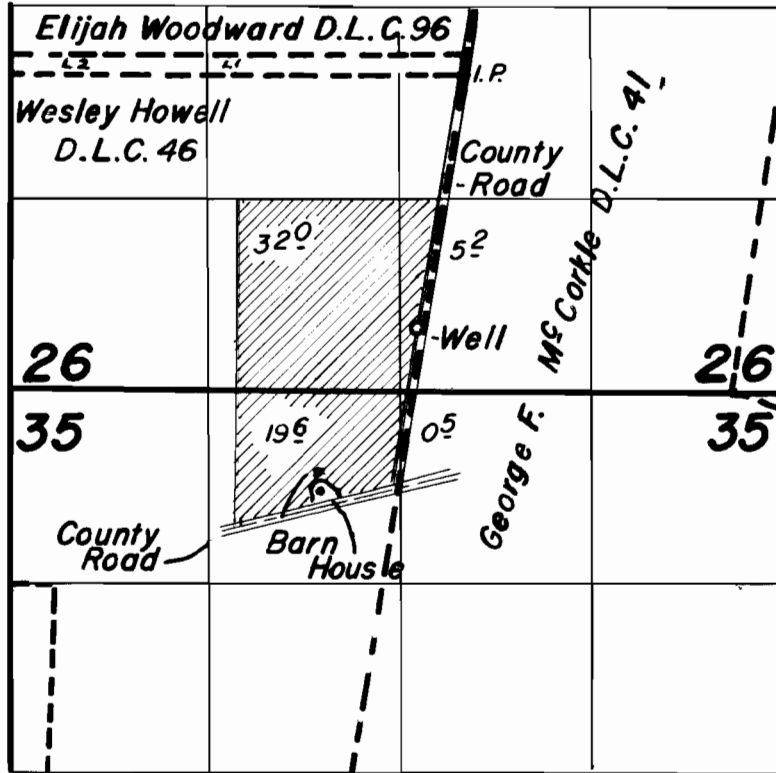

FINAL PROOF SURVEY
UNDER

Application No. G-2324 Permit No. G-2149
IN NAME OF

Howard H. Austin

Surveyed Aug. 23 1963, by Floyd L. Siegmund