


T.10S.R.3W.W.M.

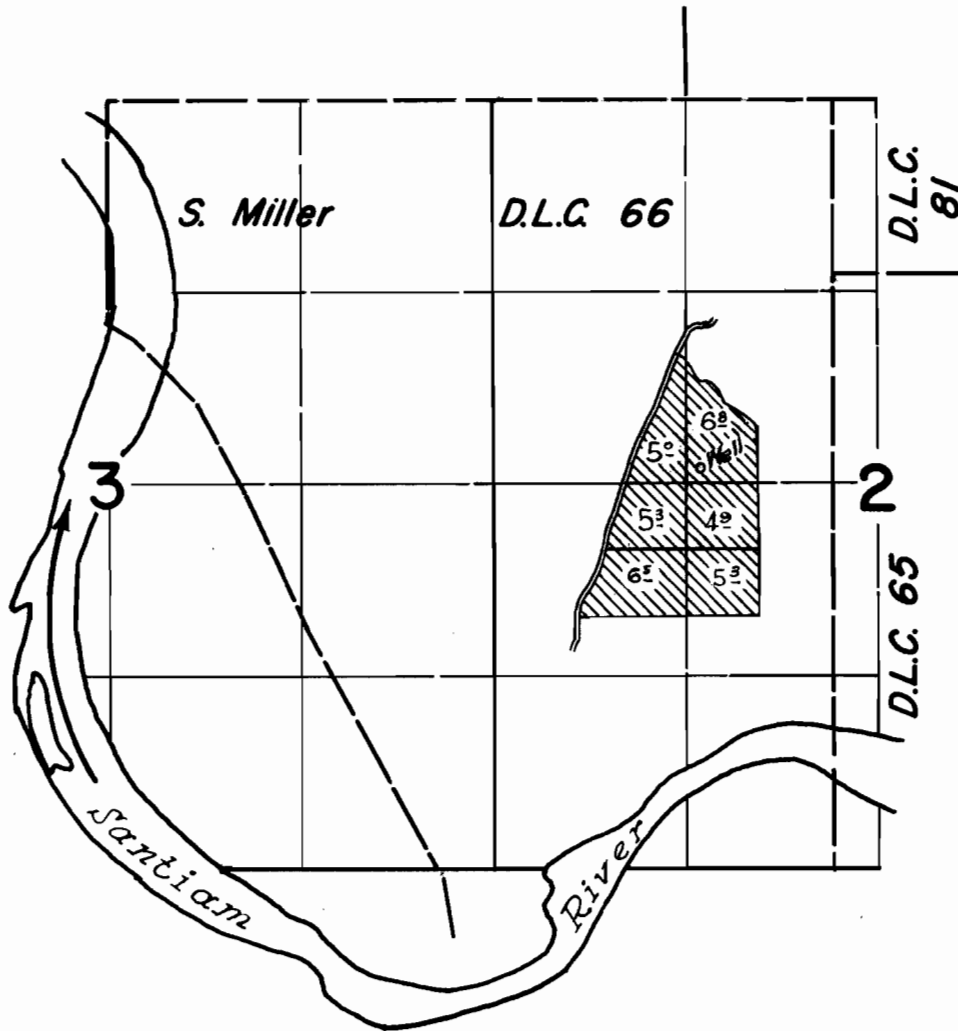

FINAL PROOF SURVEY UNDER

Application No. G-1732 Permit No. G-1585.
IN NAME OF

MRS. FORREST H. MILLER

Surveyed June 21, 1962, by *[Signature]*