


T. 7 S. R. 1 W. W. M.

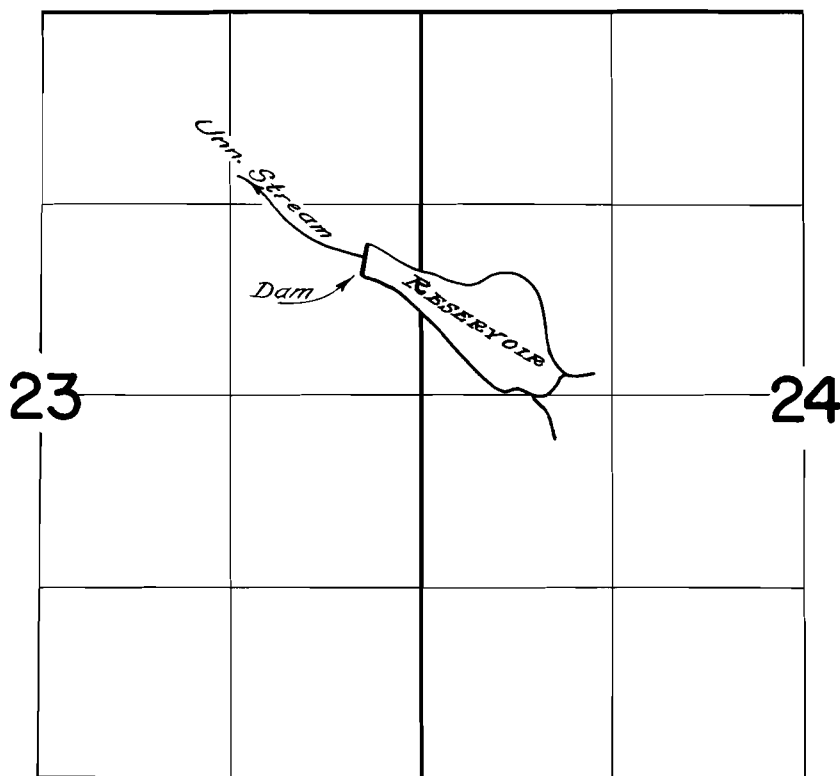

FINAL PROOF SURVEY
UNDER

Application No. ^{R-31651} 31652 Permit No. ^{R-2051} 25025
IN NAME OF

..... ELMER LORENCE

Surveyed MAR. 21 1961, by C.O. Bantels.....