


T. 7 S. R. 2 W. W. M.

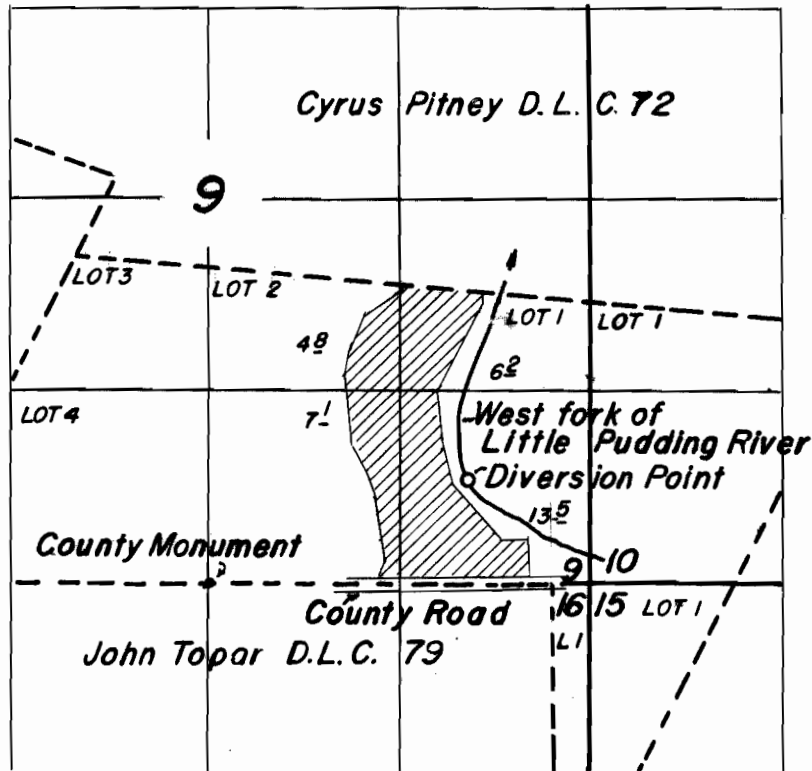

**FINAL PROOF SURVEY**  
UNDER

Application No. 33/93 Permit No. 26251  
IN NAME OF

Harold C. Toelle

Surveyed Aug. 20 1963, by Floyd L. Siegmund