


T. 9 S. R. 1 W. W. M.

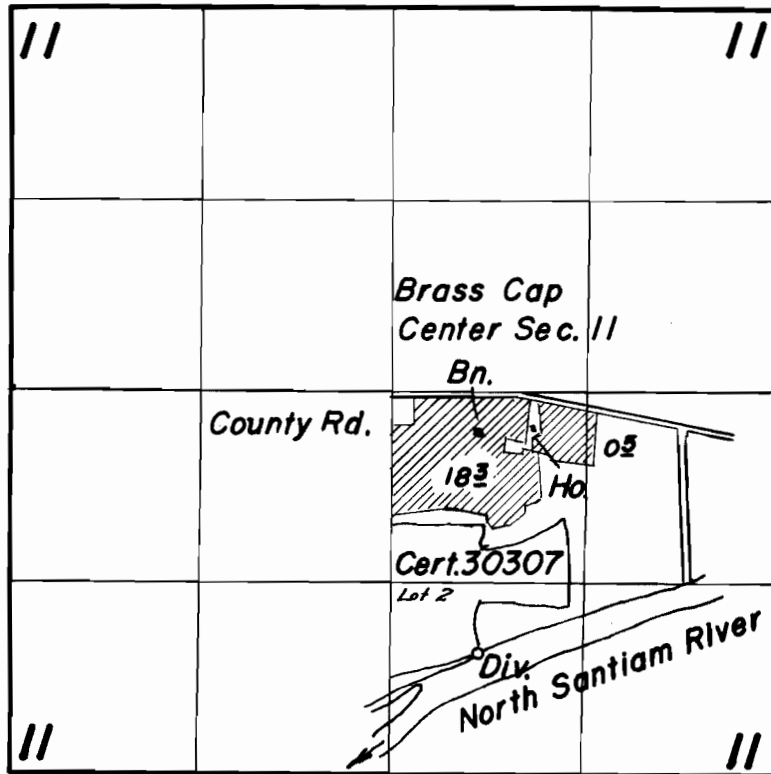

**FINAL PROOF SURVEY**  
UNDER

Application No. 37598 Permit No. 28040  
IN NAME OF

Orville J. Poole

Surveyed July 16 1963, by Floyd L. Siegmund