


T. 8 S. R. 4 W. W. M.

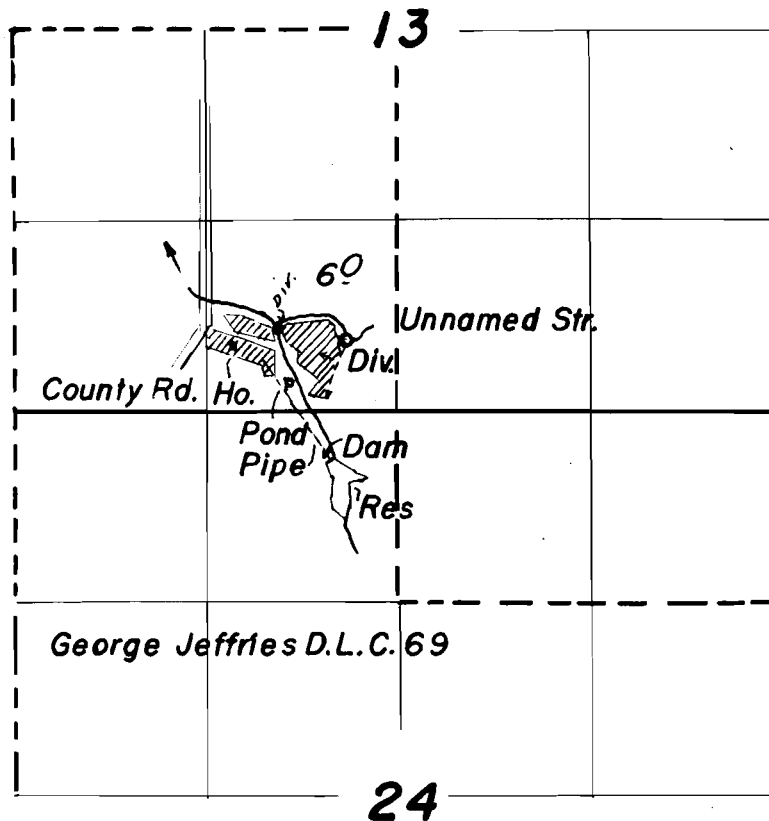

FINAL PROOF SURVEY
UNDER

Application No. R-37673 Permit No. R-2962
37674 28079
IN NAME OF

Bernard M. & Edith K. Eubanks

Surveyed July 19 1963, by Floyd L. Sigmond